

4 Cataragui Street Suite 208 Kingston, Ontario K7K 1Z7  
e-mail: szarch@kos.net tel(613)541-0776 fax(613)541-0804

This is a copyright drawing and design and shall not be used, reproduced or revised without written permission. The contractor shall check and verify all dimensions and report all errors and omissions to the architect prior to commencing work. These drawings are not to be scaled. Any deviation in construction from the information shown on these drawings without written approval of the Architect is solely the responsibility of the Constructor.

**keen** ENGINEERING CO. LTD.  
Consulting Professional Engineers  
372 Bay Street - 18th Floor  
Toronto, Ontario, Canada M5H 2W9  
Tel: (416) 366-0220 Fax: (416) 366-1808  
Internet: http://www.keen.ca

- Notes:
1. REFER TO ARCHITECTURAL DRAWINGS FOR EXTENT OF DEMOLITION.
  2. SANITARY & STORM PIPING CONTRACTOR SHALL RESUME ALL EXISTING SYSTEMS WHEN EFFECTED LOCATION PRIOR TO COMMENCE WORK

AS BUILT  
DRAWING

We hereby certify that these drawings represent the building as built.

Metrin Mechanical  
Contractors Ltd.  
52 Airview Rd. Unit 1  
Rexdale, On  
M9W 4P2  
416-747-9562


Representative Signature

Micheal Morin  
Representative Name


April 18, 2003  
Date

1	As Built	April 18/03
Revision	Description	Date
Project	Clarkson Community Centre and Library	
Location	2475 Truscott Drive Mississauga, Ontario	
Client	City of Mississauga	
Drawing	GROUND FLOOR HVAC ENLARGED PLAN	
Drawn by	SJ/APS/WE	Date APRIL 18/03
File Name	75307M-4	Superseded By
Scale	1:75	Drawing Number
Project #	875307	Revision #
		M-4B

REFER TO M-4A AND M-4C FOR CONTINUATION

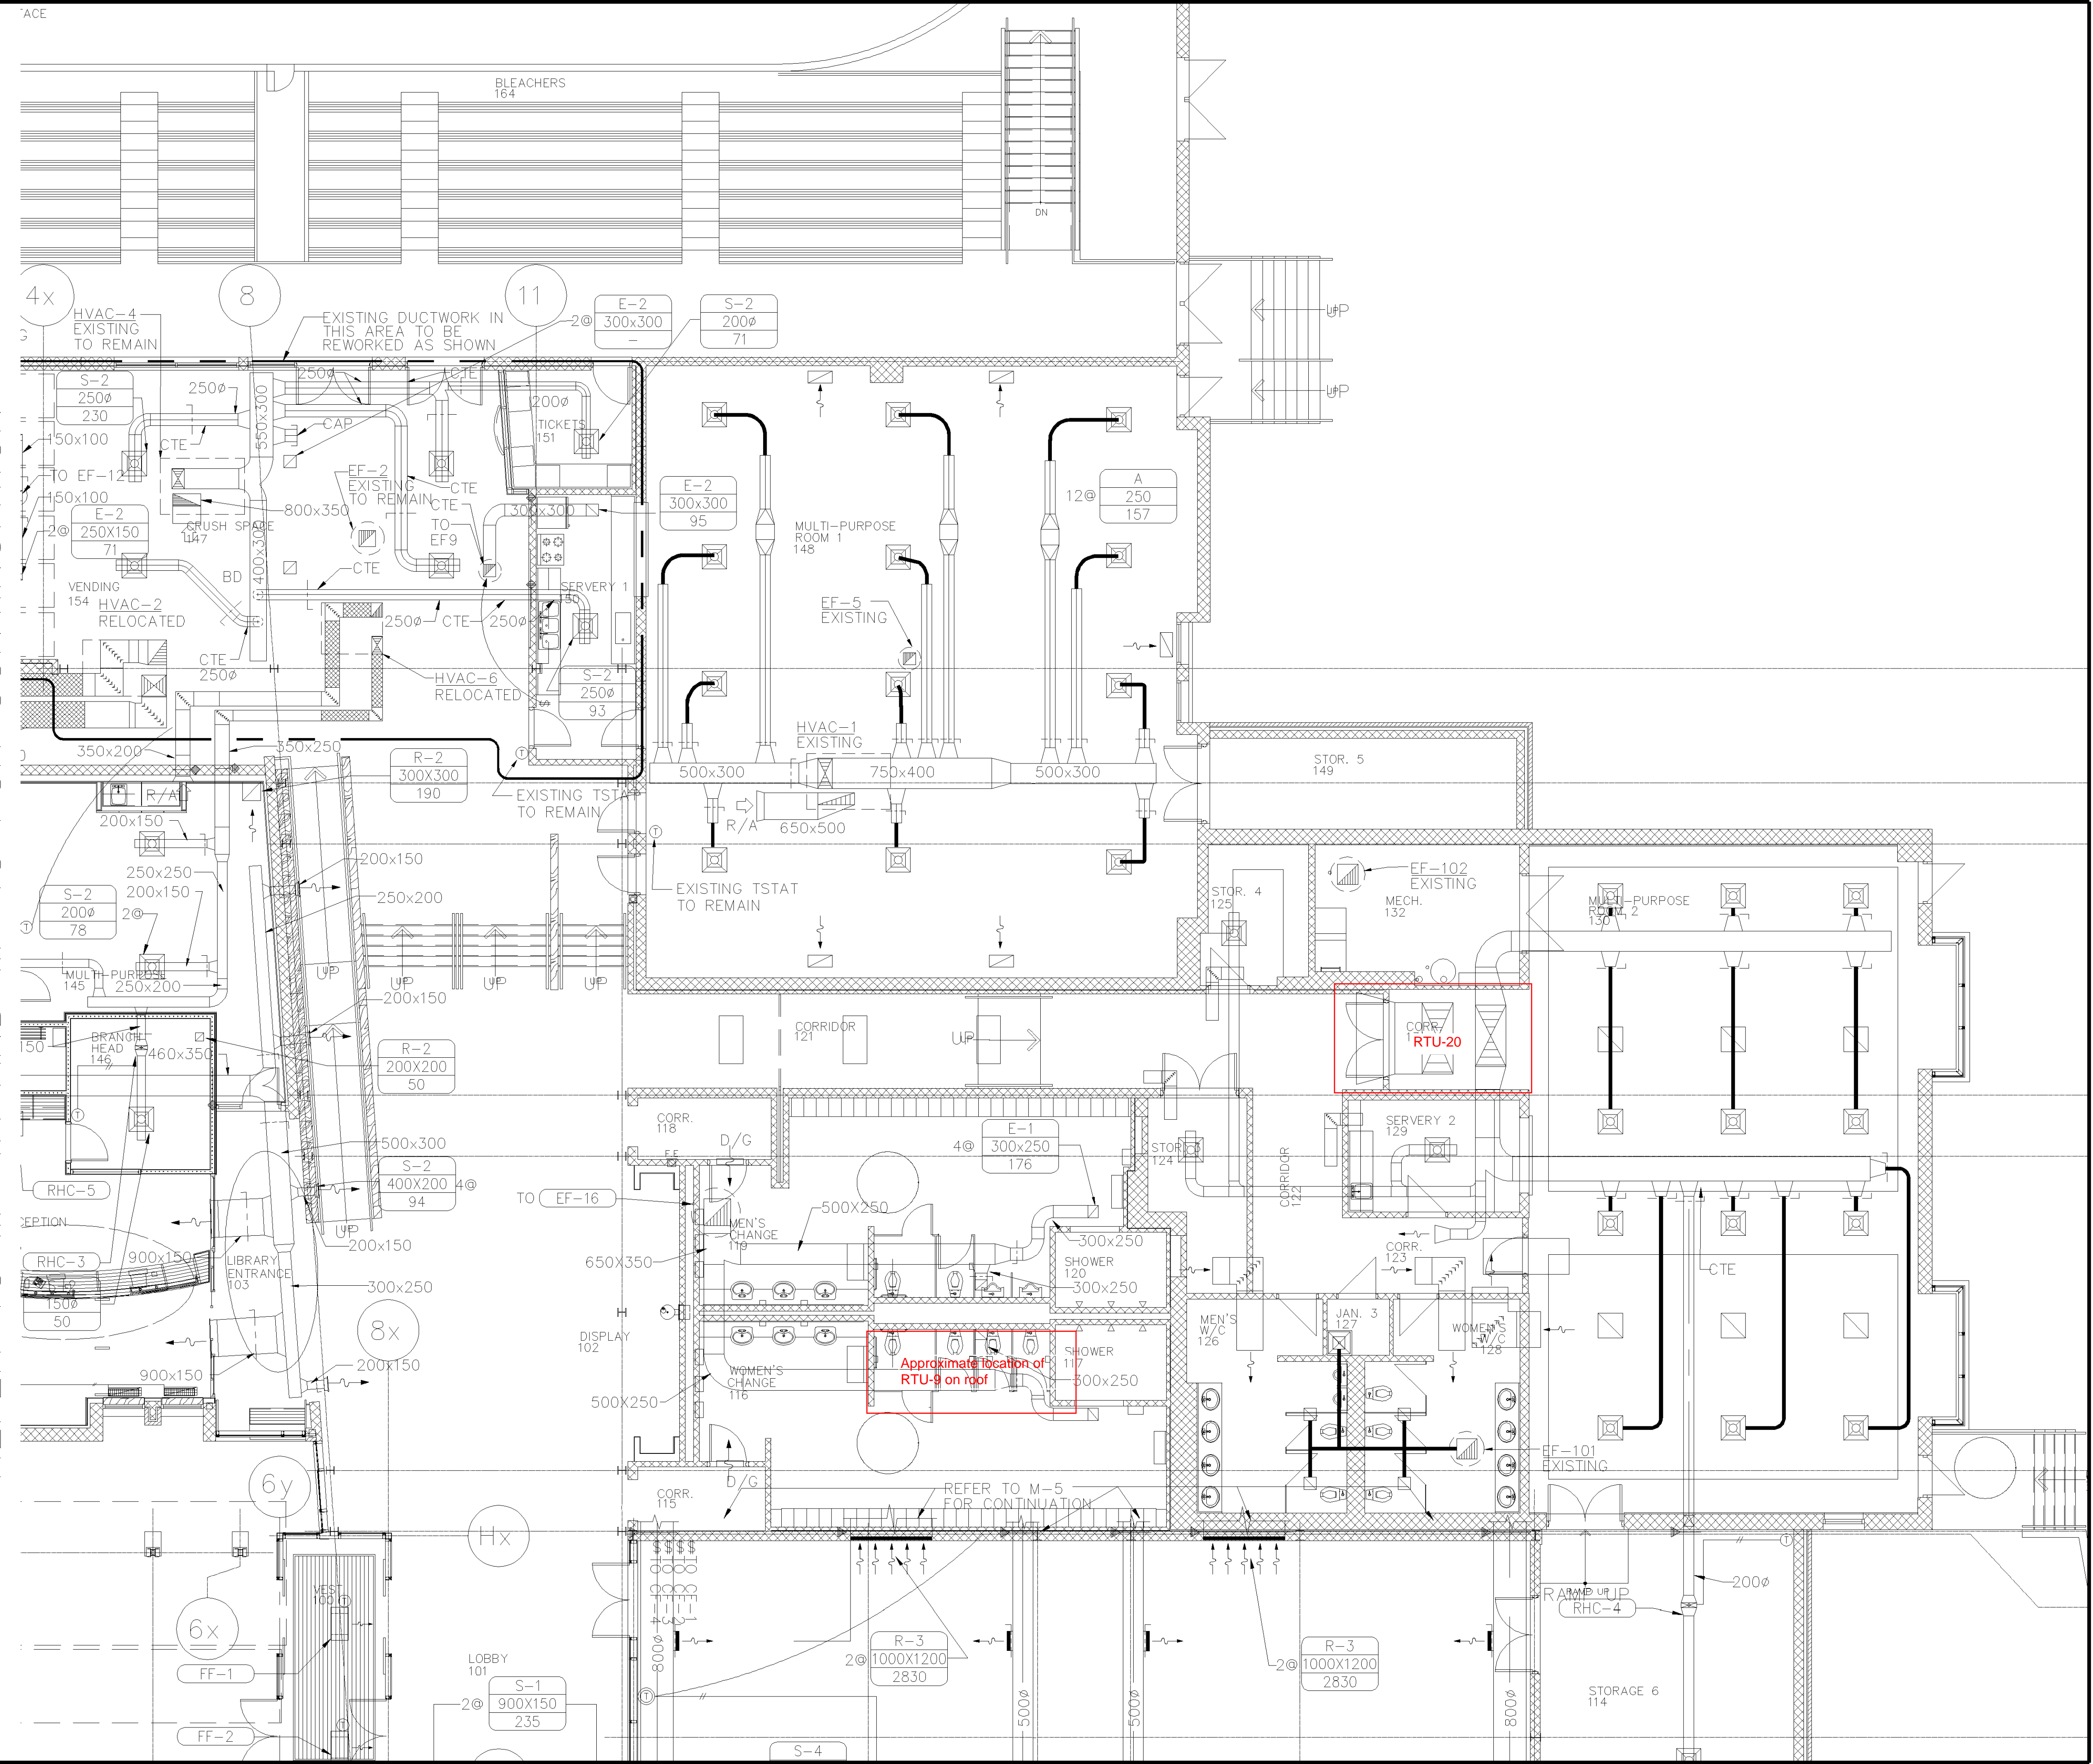



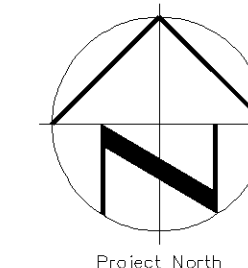

4 Catoragui Street Suite 206 Ontario K7K 1Z7  
e-mail: szach@cos.net tel(613)541-0778 fax(613)541-0804

This is a copyright drawing and design and shall not be used, reproduced or revised without written permission. The contractor shall check and verify all dimensions and report all errors and omissions to the architect prior to commencing work. These drawings are not to be scaled. Any deviation in construction from the information shown on these drawings without written approval of the Architect is solely the responsibility of the Contractor.

**keen** ENGINEERING CO. LTD.  
Consulting Professional Engineers  
372 Bay Street - 18th Floor  
Toronto, Ontario, Canada M5H 2W9  
Tel: (416) 366-0220 Fax: (416) 366-1808  
Internet: http://www.keen.ca

- Notes:
1. REFER TO ARCHITECTURAL DRAWINGS FOR EXTENT OF DEMOLITION.
  2. SANITARY & STORM PIPING IN ALL EXISTING FLOORS SHALL BE MAINTAINED PRIOR TO COMMENCE WORK

AS BUILT  
DRAWING

We hereby certify that these drawings represent the building as built.


Metrin Mechanical Contractors Ltd.  
52 Airview Rd. Unit 1  
Rexdale, On  
M9W 4P2  
416-747-9562


Representative Signature

Micheal Morin  
Representative Name

April 18, 2003  
Date

1	As Built	April 18/03
Revision	Description	Date
Project		
Clarkson Community Centre and Library		
Location		
2475 Truscott Drive Mississauga, Ontario		
Client		
City of Mississauga		
Drawing		
GROUND FLOOR HVAC ENLARGED PLAN		
Drawn by		Date
S.J./APS/WE		APRIL 18/03
File Name	Supersedes	Superseded By
75307M-4	JUC/SPS	
Scale	Drawing Number	
1:75		
Project #	Revision #	
875307	4	M-4C

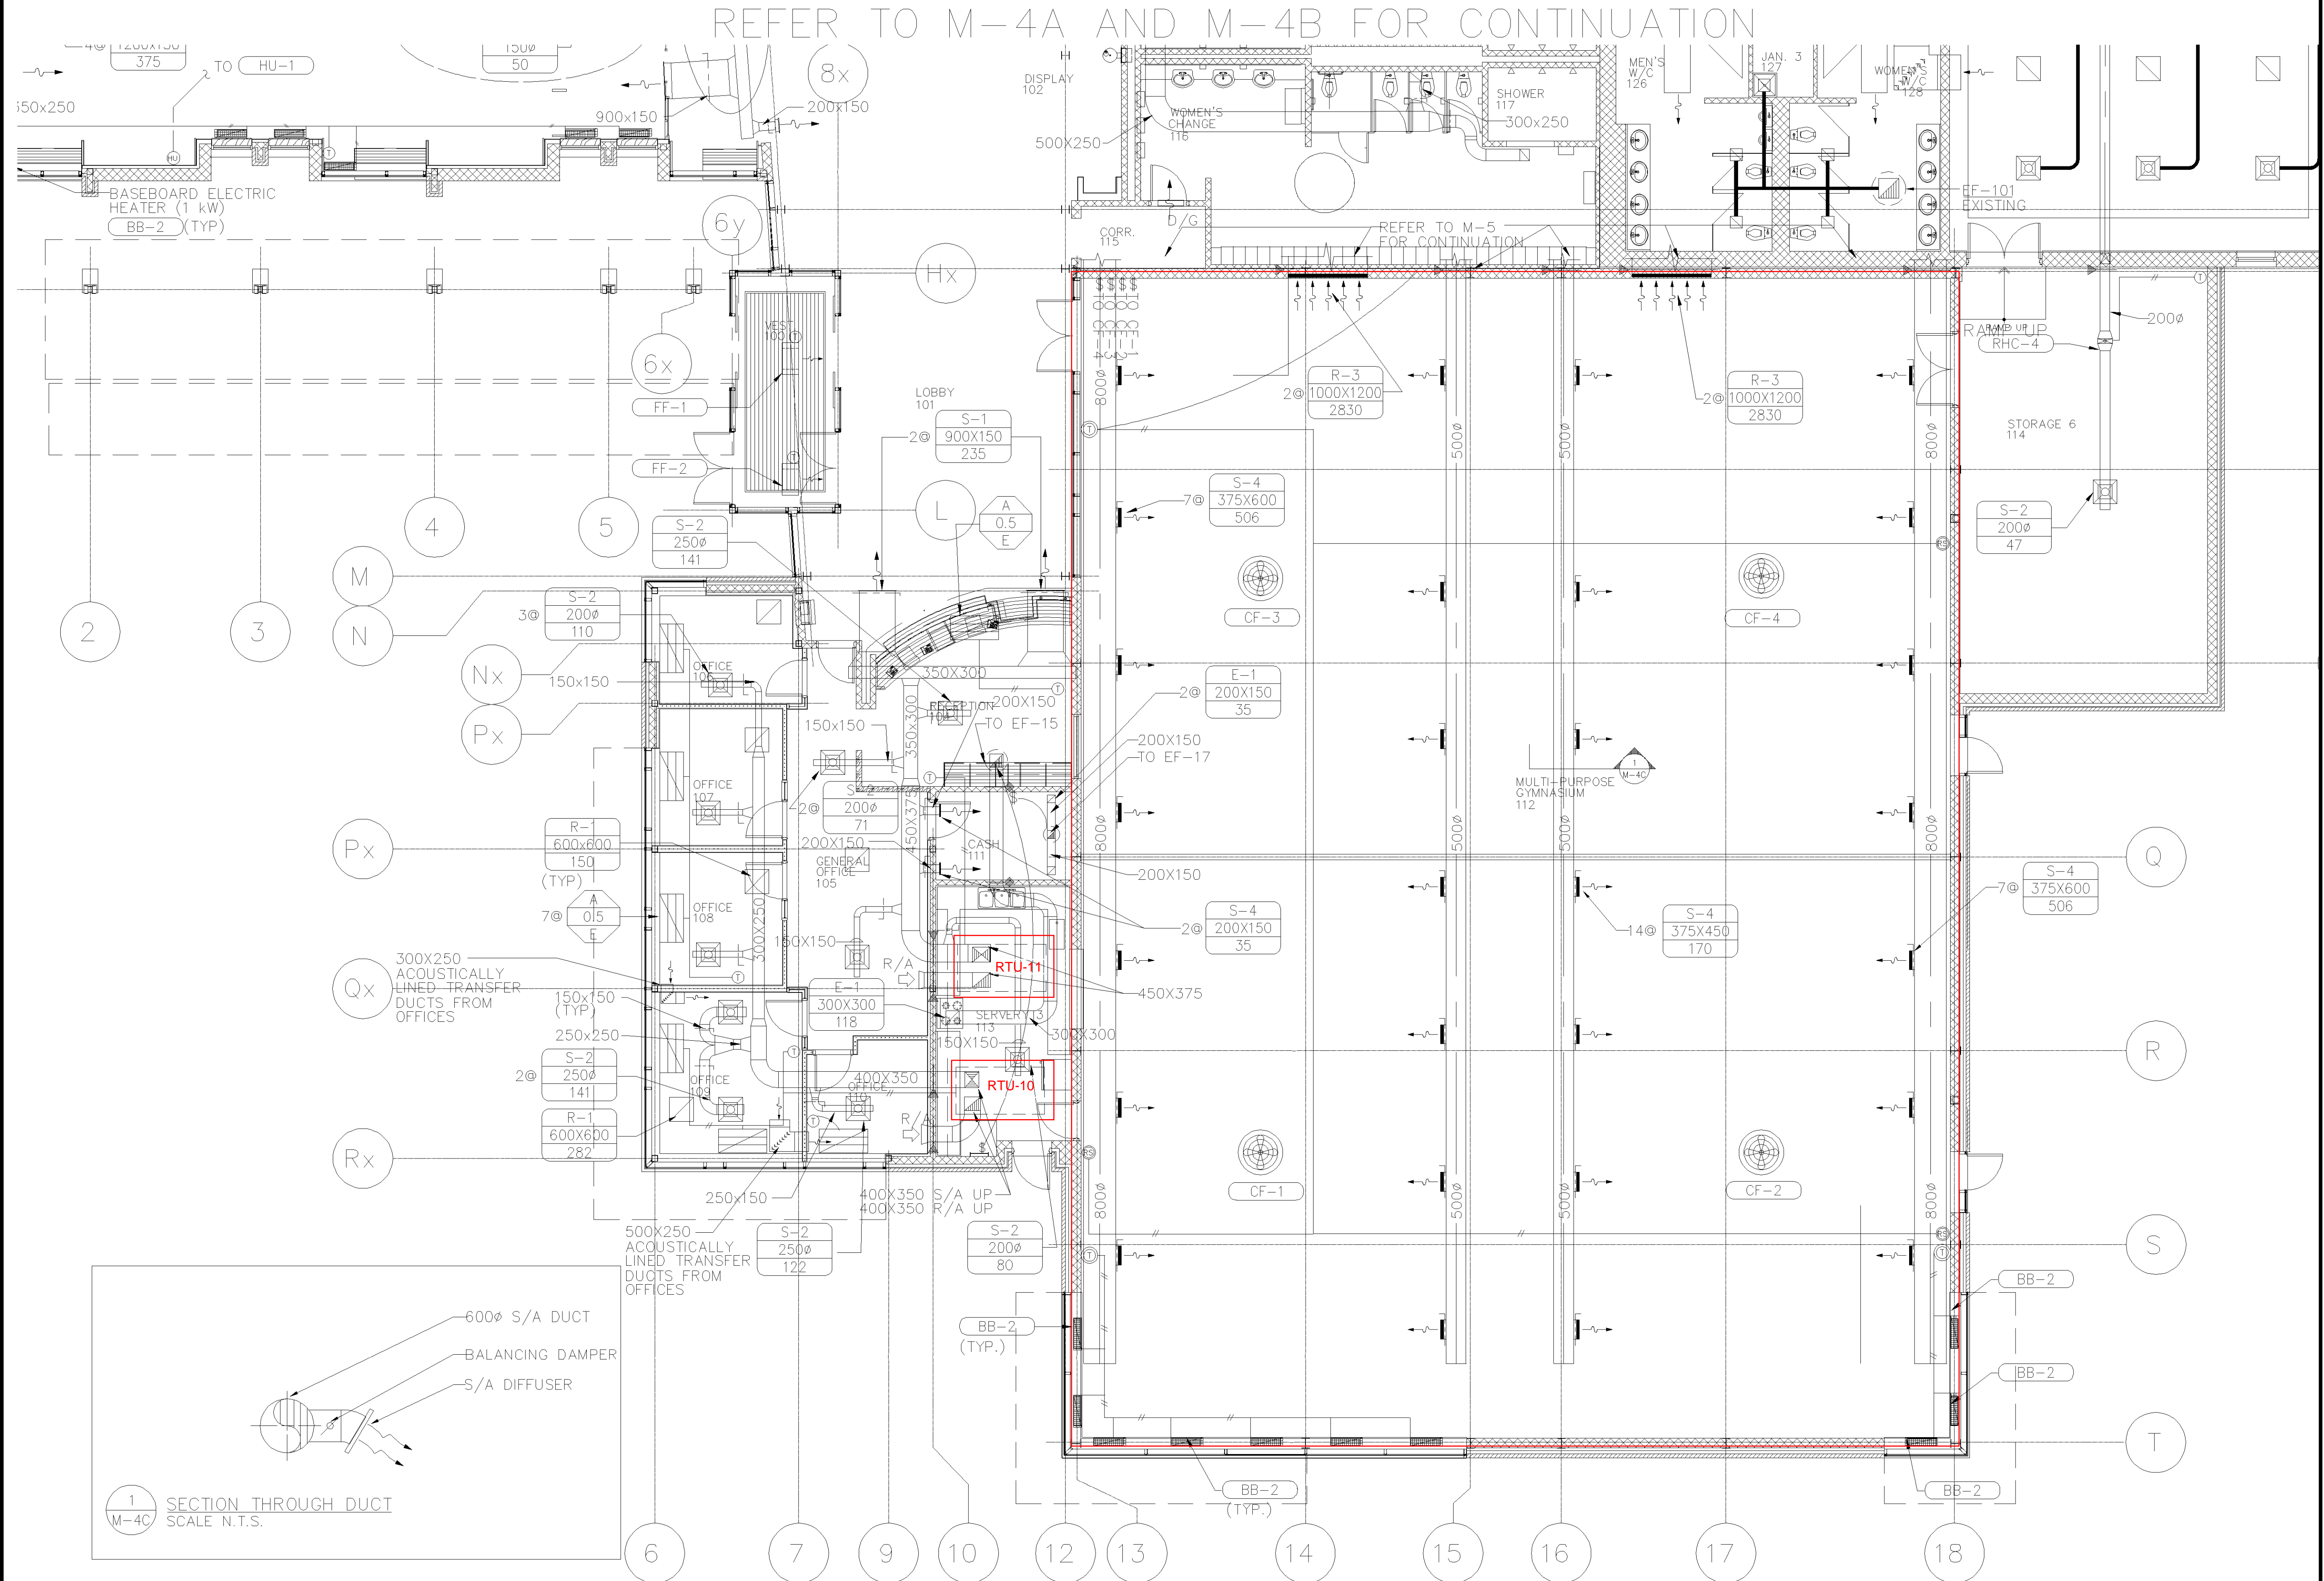

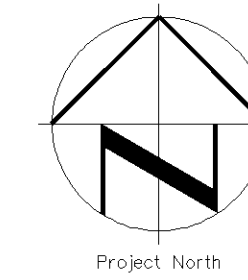

4 Catoragui Street Suite 206 Kingston, Ontario K7K 1Z7  
e-mail: szorch@kos.net tel(613)541-0776 fax(613)541-0804

This is a copyright drawing and design and shall not be used, reproduced or revised without written permission. The contractor shall check and verify all dimensions and report all errors and omissions to the architect prior to commencing work. These drawings are not to be scaled. Any deviation in construction from the information shown on these drawings without written approval of the Architect is solely the responsibility of the Contractor.

**keen** ENGINEERING CO. LTD.

Consulting Professional Engineers  
372 Bay Street - 18th Floor  
Toronto, Ontario, Canada - M5H 2W9  
Tel: (416) 366-0220 Fax: (416) 366-1808  
Internet: http://www.keen.ca

#### Notes:

1. REFER TO ARCHITECTURAL DRAWINGS FOR EXTENT OF DEMOLITION.
2. SANITARY & STORM PIPING LOCATIONS ARE APPROXIMATE. CONTRACTOR TO REVIEW EXACT LOCATION PRIOR TO COMMENCE WORK

## AS BUILT DRAWING

We hereby certify that these drawings represent the building as built.

Metrin Mechanical Contractors Ltd.  
52 Airview Rd. Unit 1  
Rexdale, On  
M9W 4P2  
416-747-9562

Representative Signature

Micheal Morin  
Representative Name

April 18, 2003  
Date

1 As Built April 18/03  
Revision Description Date

Project  
Clarkson Community Centre and Library

Location  
2475 Truscott Drive  
Mississauga, Ontario

Client  
City of Mississauga

Drawing  
ROOF PLAN  
PLUMBING & DRAINAGE  
& HVAC

Drawn by  
SJ/APS/WE Date  
APRIL 18/03

File Name  
JUC/SPS Superseded By

Scale  
1:150 Drawing Number

Project #  
875307 Revision #  
4 M-5

