




1 ENLARGED PLAN STORES AREA - HVAC
SCALE 1:100
M52-01-02

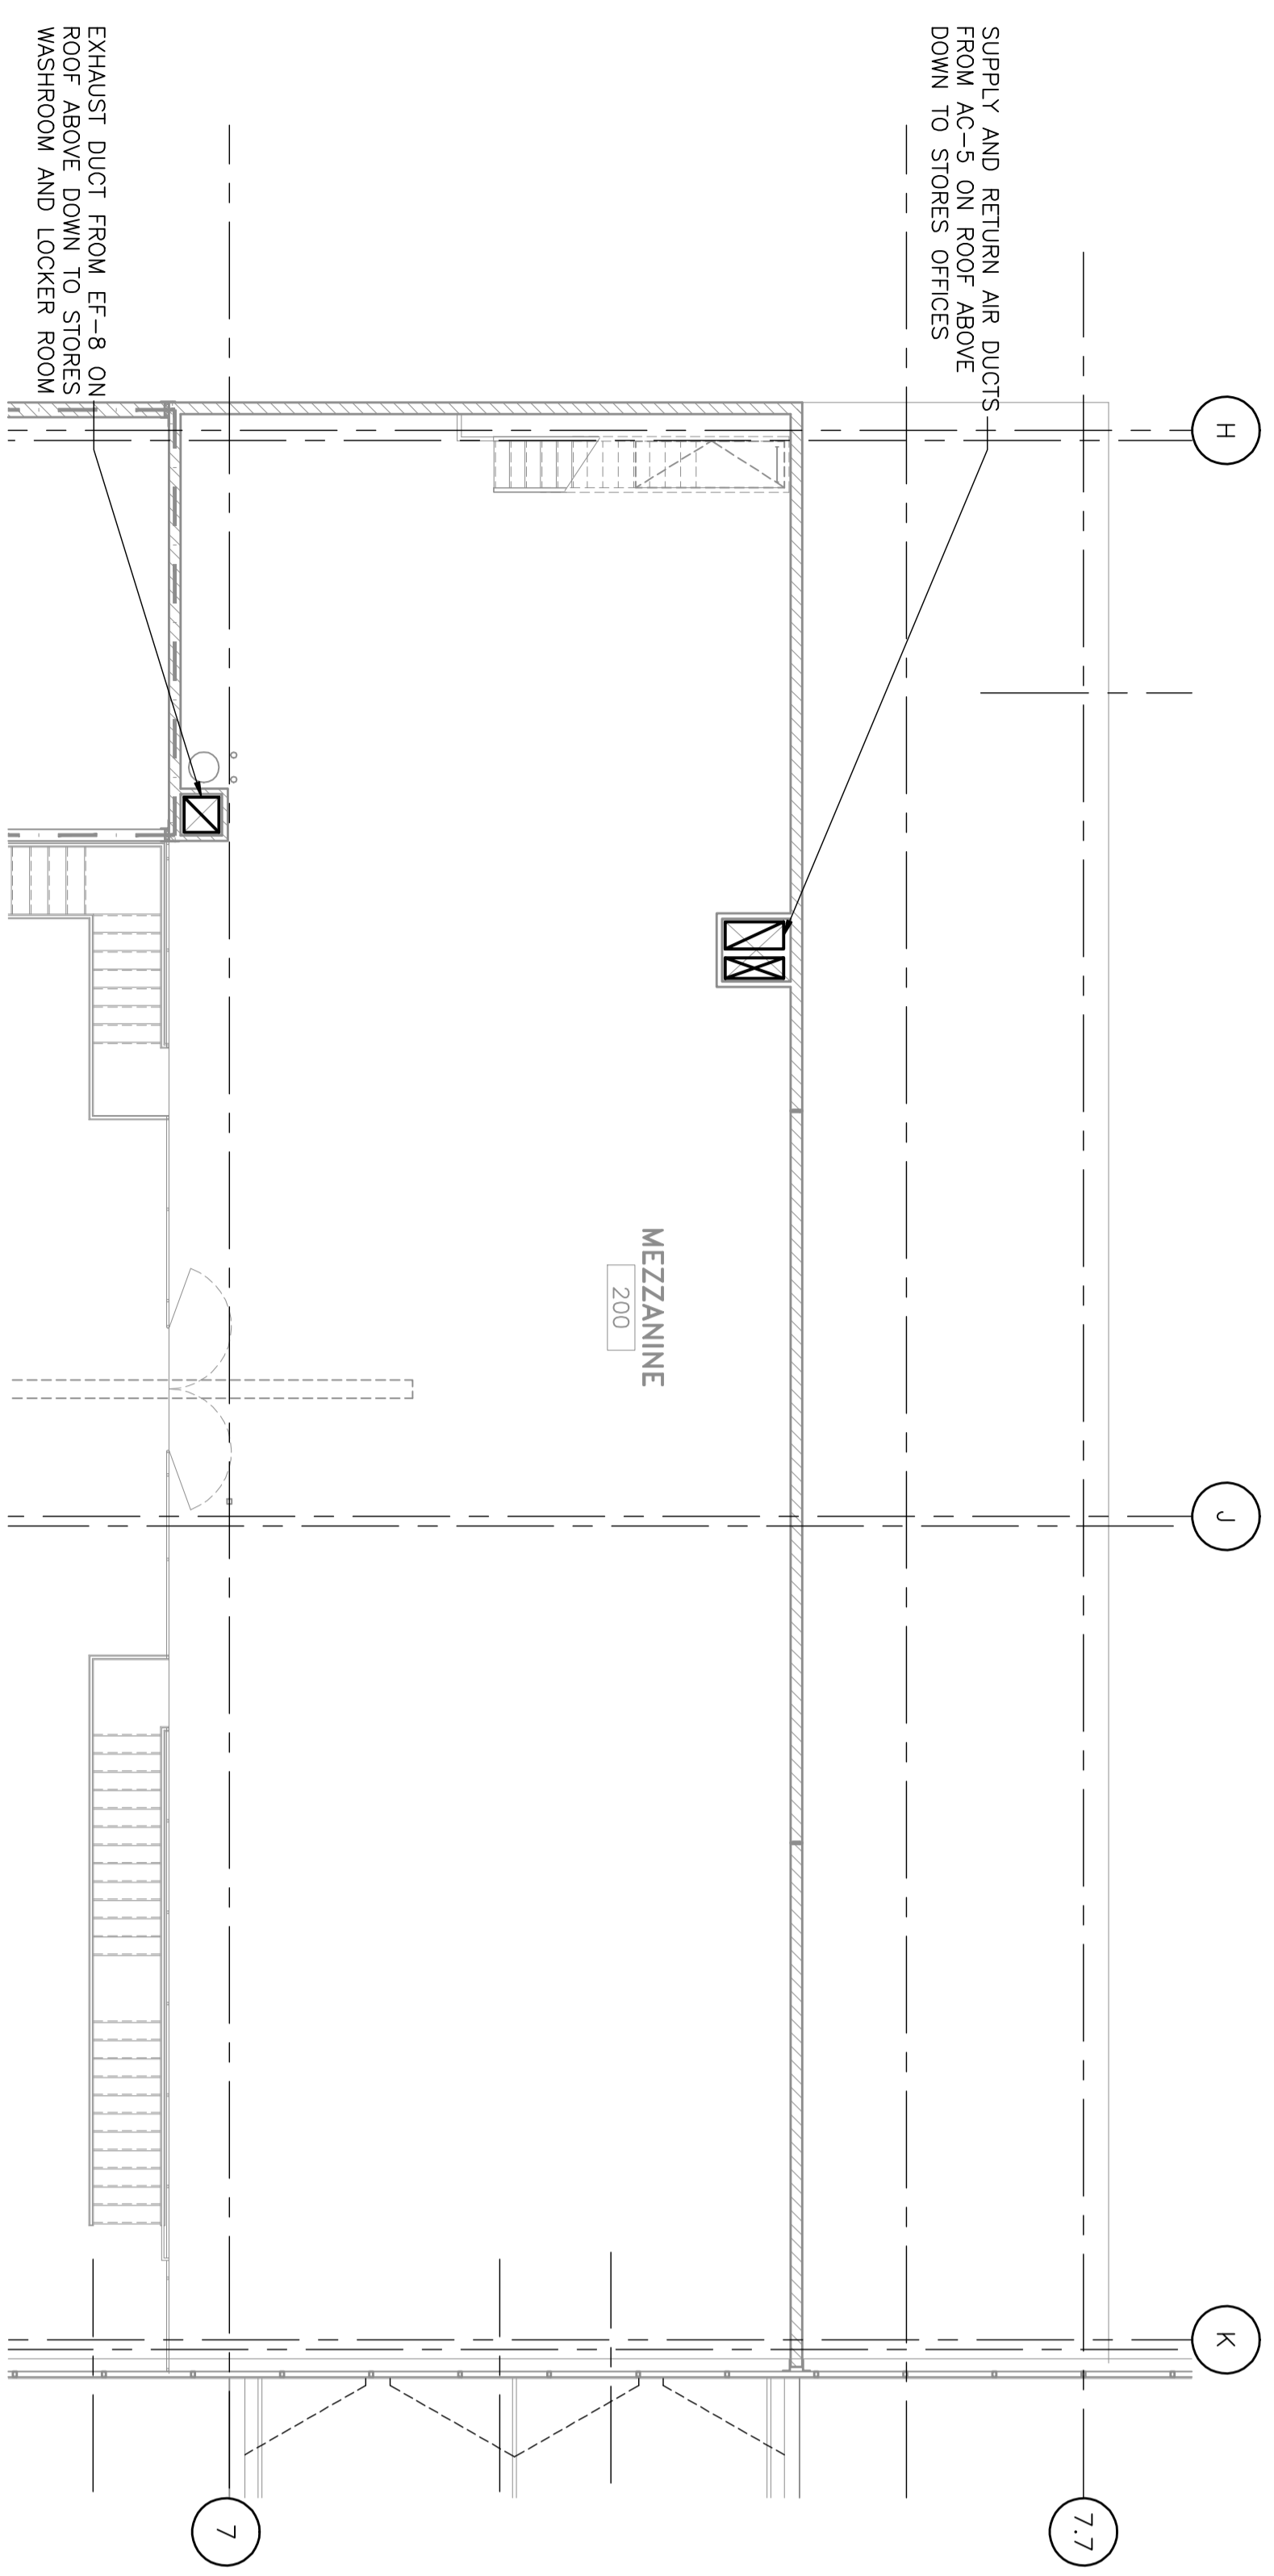

3 ENLARGED MEZZANINE PART PLAN - HVAC
SCALE 1:100
M52-01-02

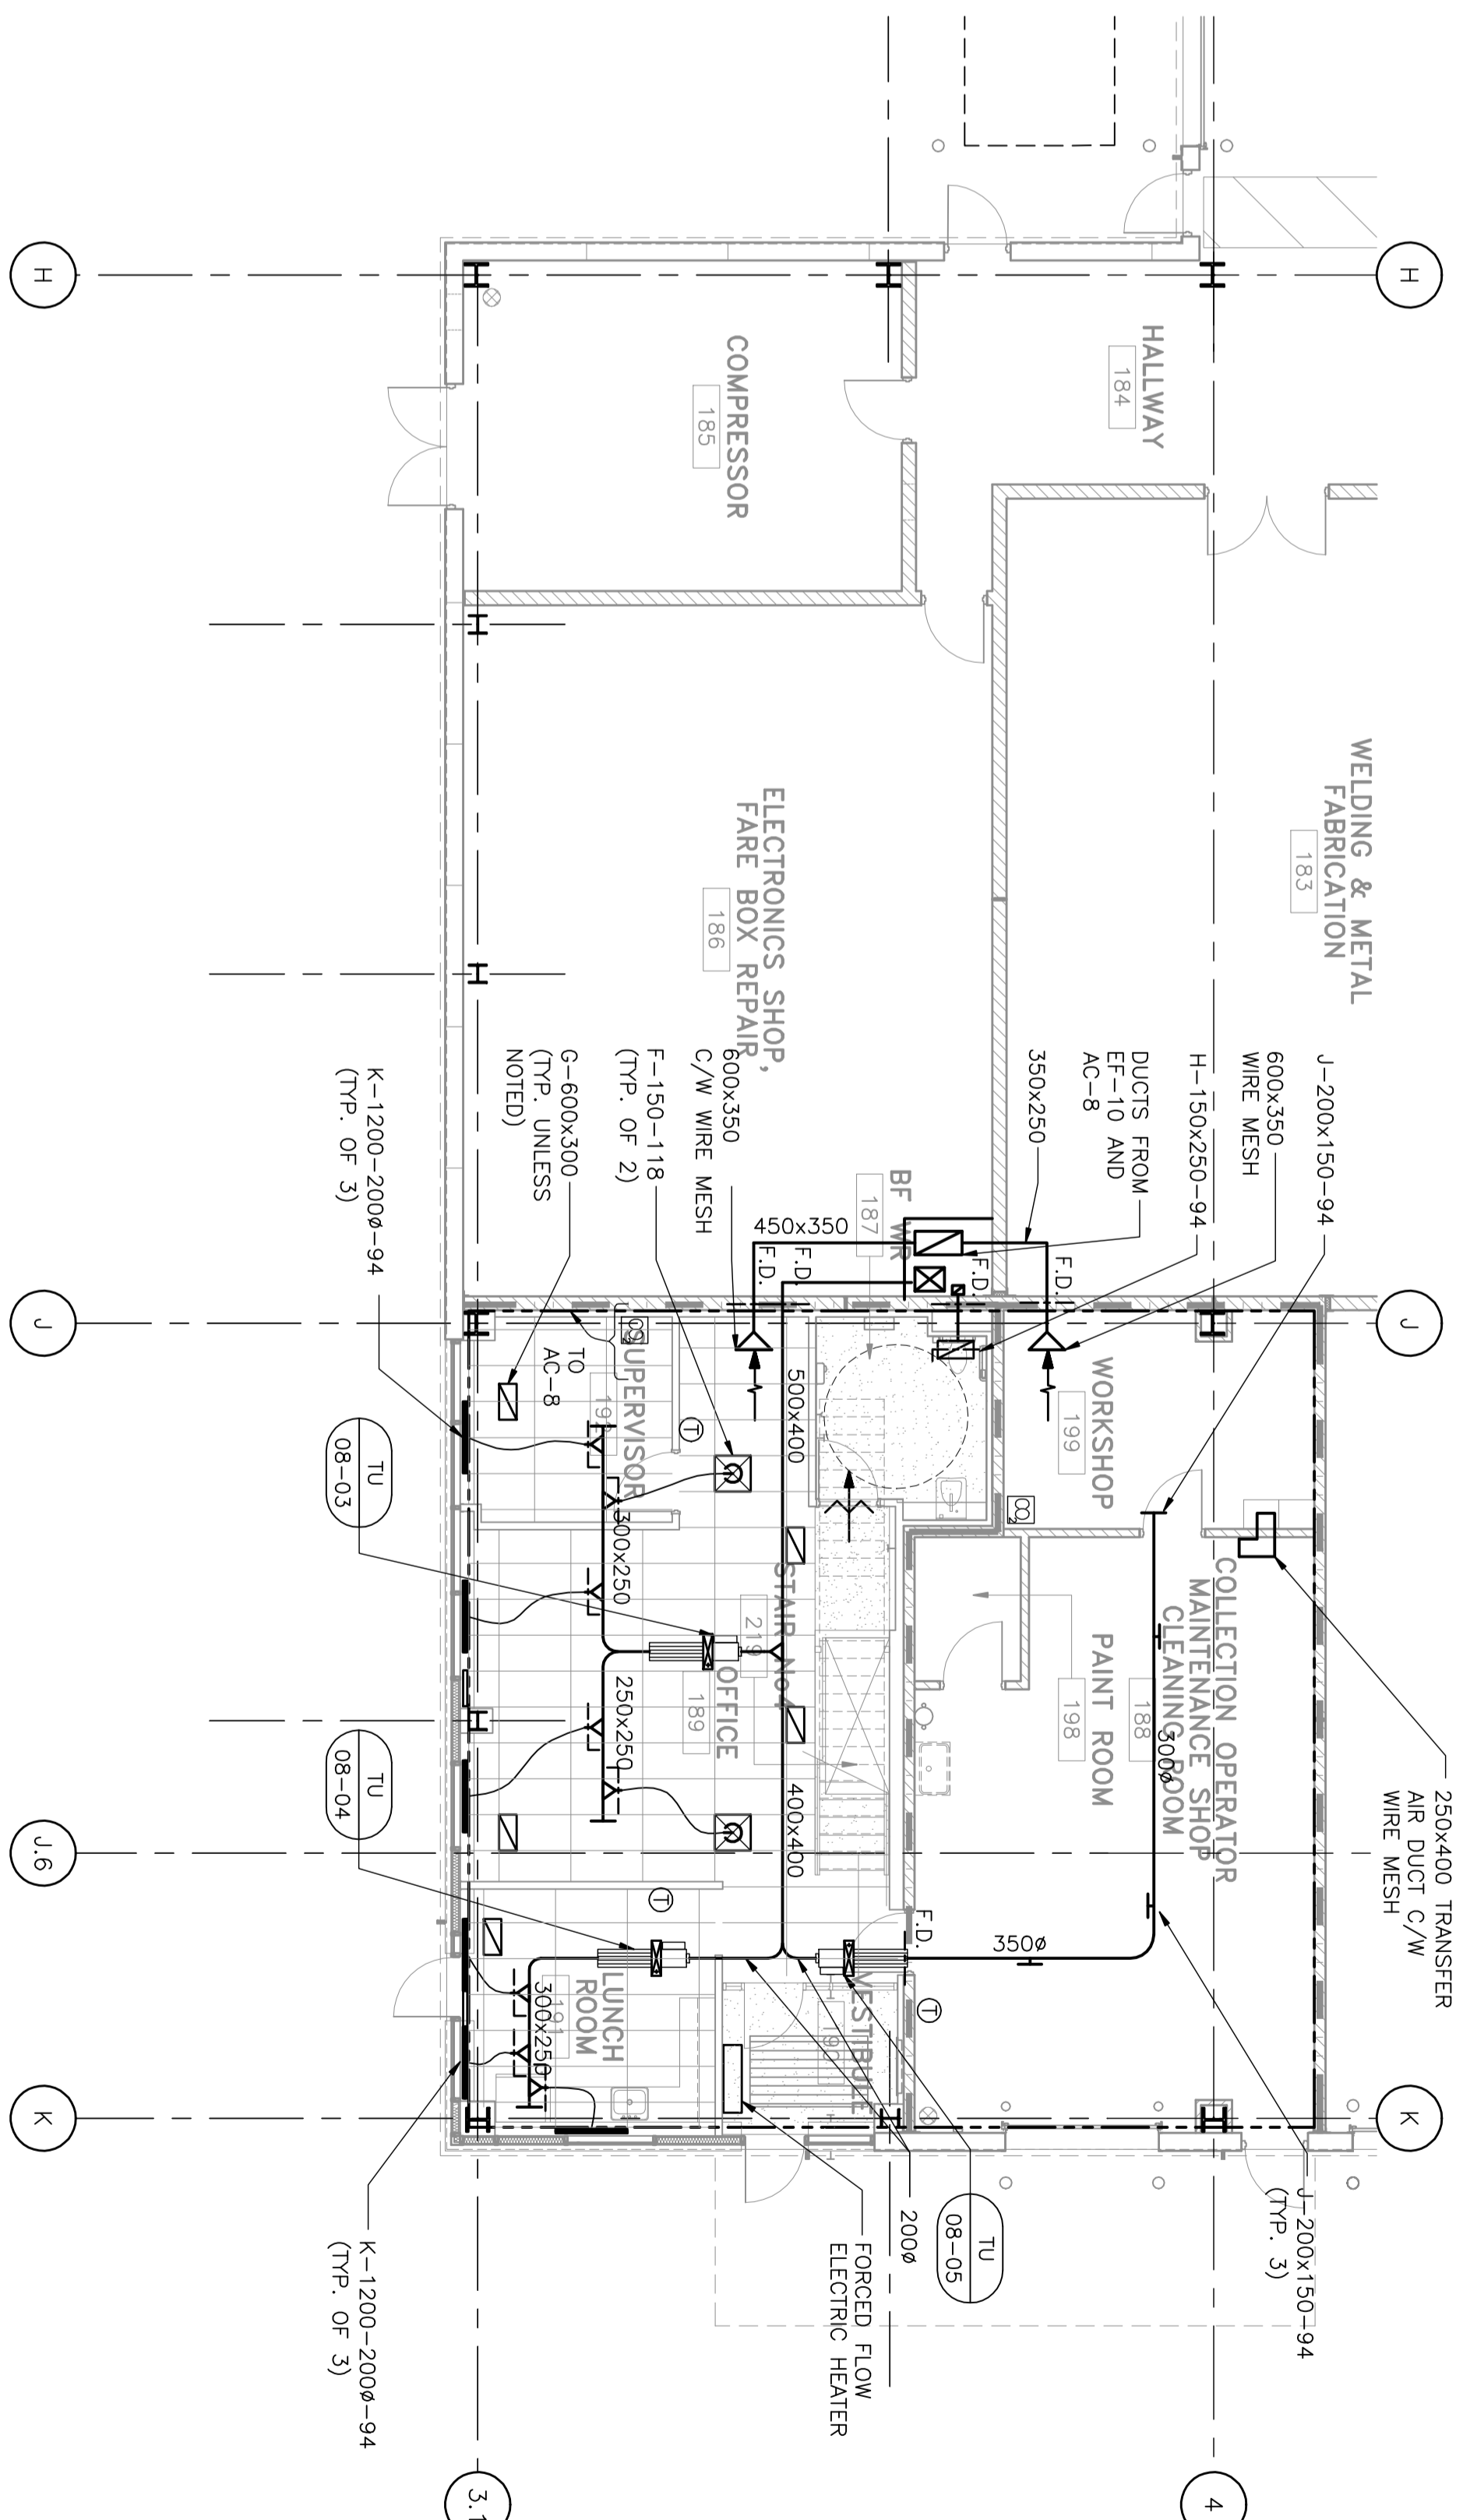

2 ENLARGED PLAN STORES AREA - HVAC
SCALE 1:100
M52-01-02

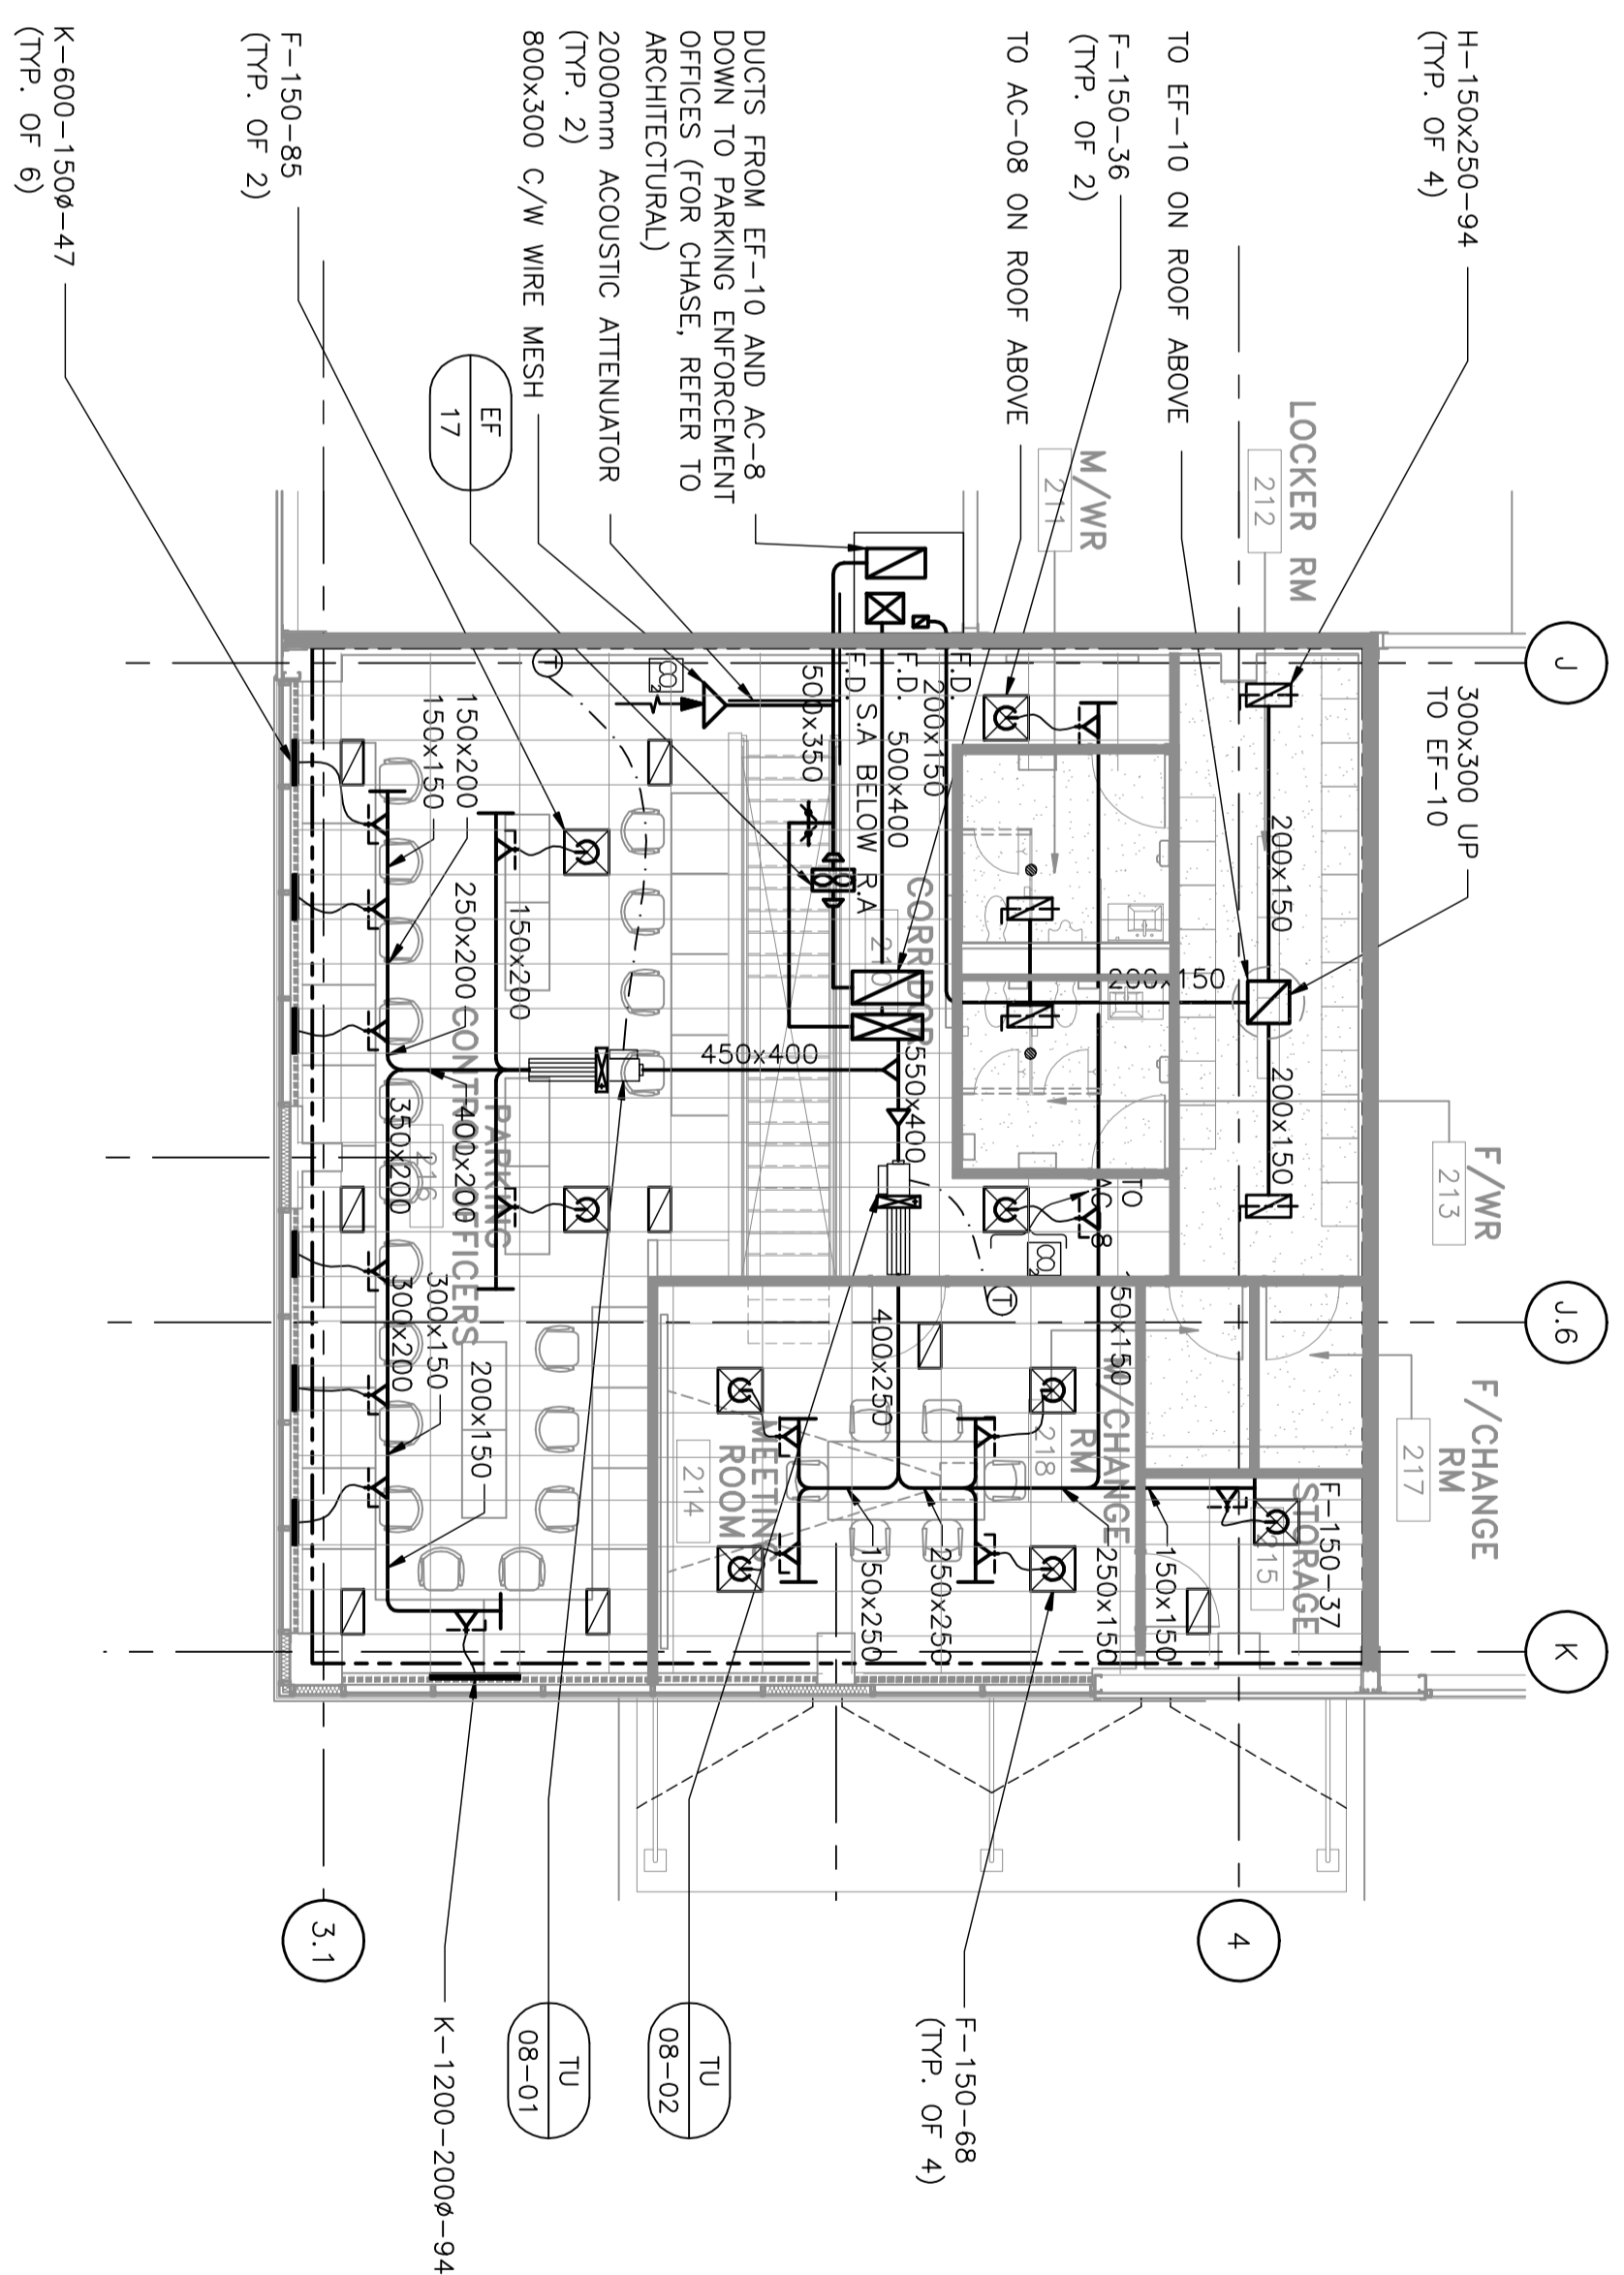

4 ENLARGED MEZZANINE PART PLAN - HVAC
SCALE 1:100
M52-01-02

- NOTES:
1. DUCT SIZE INDICATED ON DUCT SCHEDULE IS DUCT SCHEDULE NUMBER.

DATE	ISSUED FOR	REV
SEP 21 2009	ISS TRUCK ROOM	A
OCT 30 2009	ISS TRUCK ROOM / REAR ROOM	B
NOV 04 2009	ISS REAR	C
NOV 09 2009	CONSTRUCTION	D
DEC 01 2009	ASBROOK	E
MAY 20 2011	REVISION	2

KEY PLAN

DISCLAIMER
THE ISSUANCE OF THIS RECORD DRAWING IS A REPRESENTATION BY THE ARCHITECT AND NOT AN ATTESTATION OF THE BUILDING OR EQUIPMENT OR ALTERNATION OF THE BUILDING IN GENERAL, AS PROPOSED TO BE CONFORMANT WITH THE DESIGN ENGINEER, BUT IS NOT A REPRESENTATION THAT THE BUILDING IS IN CONFORMANCE WITH A DESIGN THAT HAS BEEN PREPARED OR PROVIDED BY OTHERS. THE ARCHITECT'S RESPONSIBILITY IS LIMITED TO THE REFLECTING THE SIGNIFICANT CHANGES IN THE WORK MADE DURING CONSTRUCTION AND BASED ON DESIGN INFORMATION PROVIDED BY THE OWNER. THE ARCHITECT AND/OR ENGINEER SHALL NOT BE HELD RESPONSIBLE FOR THE ACCURACY OR COMPLETENESS OF THE INFORMATION PROVIDED BY THE CONTRACTOR.




Architects



Giftels Associates Limited / IBI Group

30 International Blvd, Toronto ON, M4W 3P3 Canada
Tel: 416 678-1800 Fax: 416 678-4000

This drawing has been prepared solely for the use of the project named herein. It is not to be used for any other project without the written consent of the Architect. Any reproduction or use of this drawing without the written consent of the Architect is prohibited.

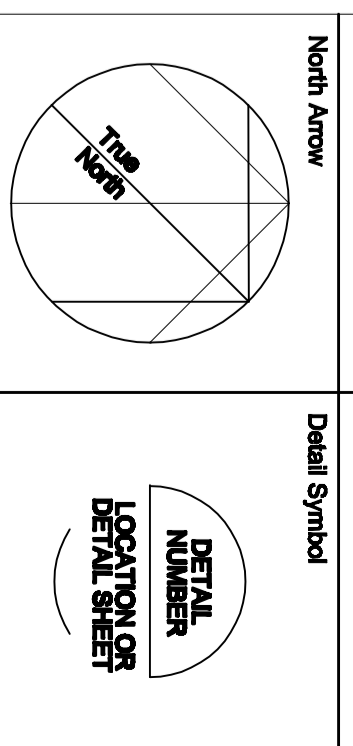

Project Manager	Architect/Engineer
G. VERNESCU	G. VERNESCU
D. SAUJ	D. SAUJ
G. VERNESCU	G. VERNESCU



OAKVILLE

Project
OAKVILLE TRANSIT FACILITY
430 WECROFT RD, OAKVILLE, ONTARIO
Drawing Title
ENLARGED PLAN
STORES AREA
HVAC

Check Status (from the photo-reduced)
Project No. AAR2070085
Drawing No. M52-01-02