





NOTES	PROJECT IDENTIFICATION	DRAWING IDENTIFICATION	ORIENTATION	SUB-CONSULTANT	PRIME CONSULTANT	DISCIPLINE SEAL	DRAWING SUBMISSION(S)	INTERNAL INFO	COPYRIGHT 2024 [®]
THE CONTRACTOR SHALL CHECK AND VERIFY ALL DIMENSIONS AND REPORT ANY ERRORS OR OMISSIONS TO THE ARCHITECT PRIOR TO COMMENCING OR PROCEEDING WITH ANY WORK ON THIS PROJECT. ALL DRAWINGS AND SPECIFICATIONS ARE THE PROPERTY OF THE ARCHITECT. COPYRIGHT 2024 [®] . THESE DRAWINGS AND SPECIFICATIONS ARE DESIGNED FOR THE CLIENT AND THE PROPERTY INDICATED ON THESE DRAWINGS ONLY AND SHALL NOT BE CONSTRUCTED FOR ANY OTHER CLIENT OR ANY OTHER PROPERTY. DO NOT SCALE DRAWINGS.	BRANTFORD ANIMAL SHELTER 10 KRAEMER'S WAY BRANTFORD, ONTARIO N3V 0A5 <div><div></div>DESIGN REVIEW</div> <div><div></div>SITE PLAN APPROVAL</div> <div><div></div>BUILDING PERMIT</div> <div><div></div>BIDS DOCUMENTS</div> <div><div></div>CONTRACT DOCUMENTS</div> <div><div></div>CONSTRUCTION DOCUMENTS</div> <div><div></div>AS-BUILT</div>	WALL SECTIONS			 <div>67 KING STREET WEST, CHATHAM ON N7M 1C7</div> <div>TEL . 519.397.0943</div> <div>EMAIL . info@roastudio.com</div>		<div></div> <div></div> <		



02 WALL SECTION
A424 SCALE: 3/4" = 1'-0"

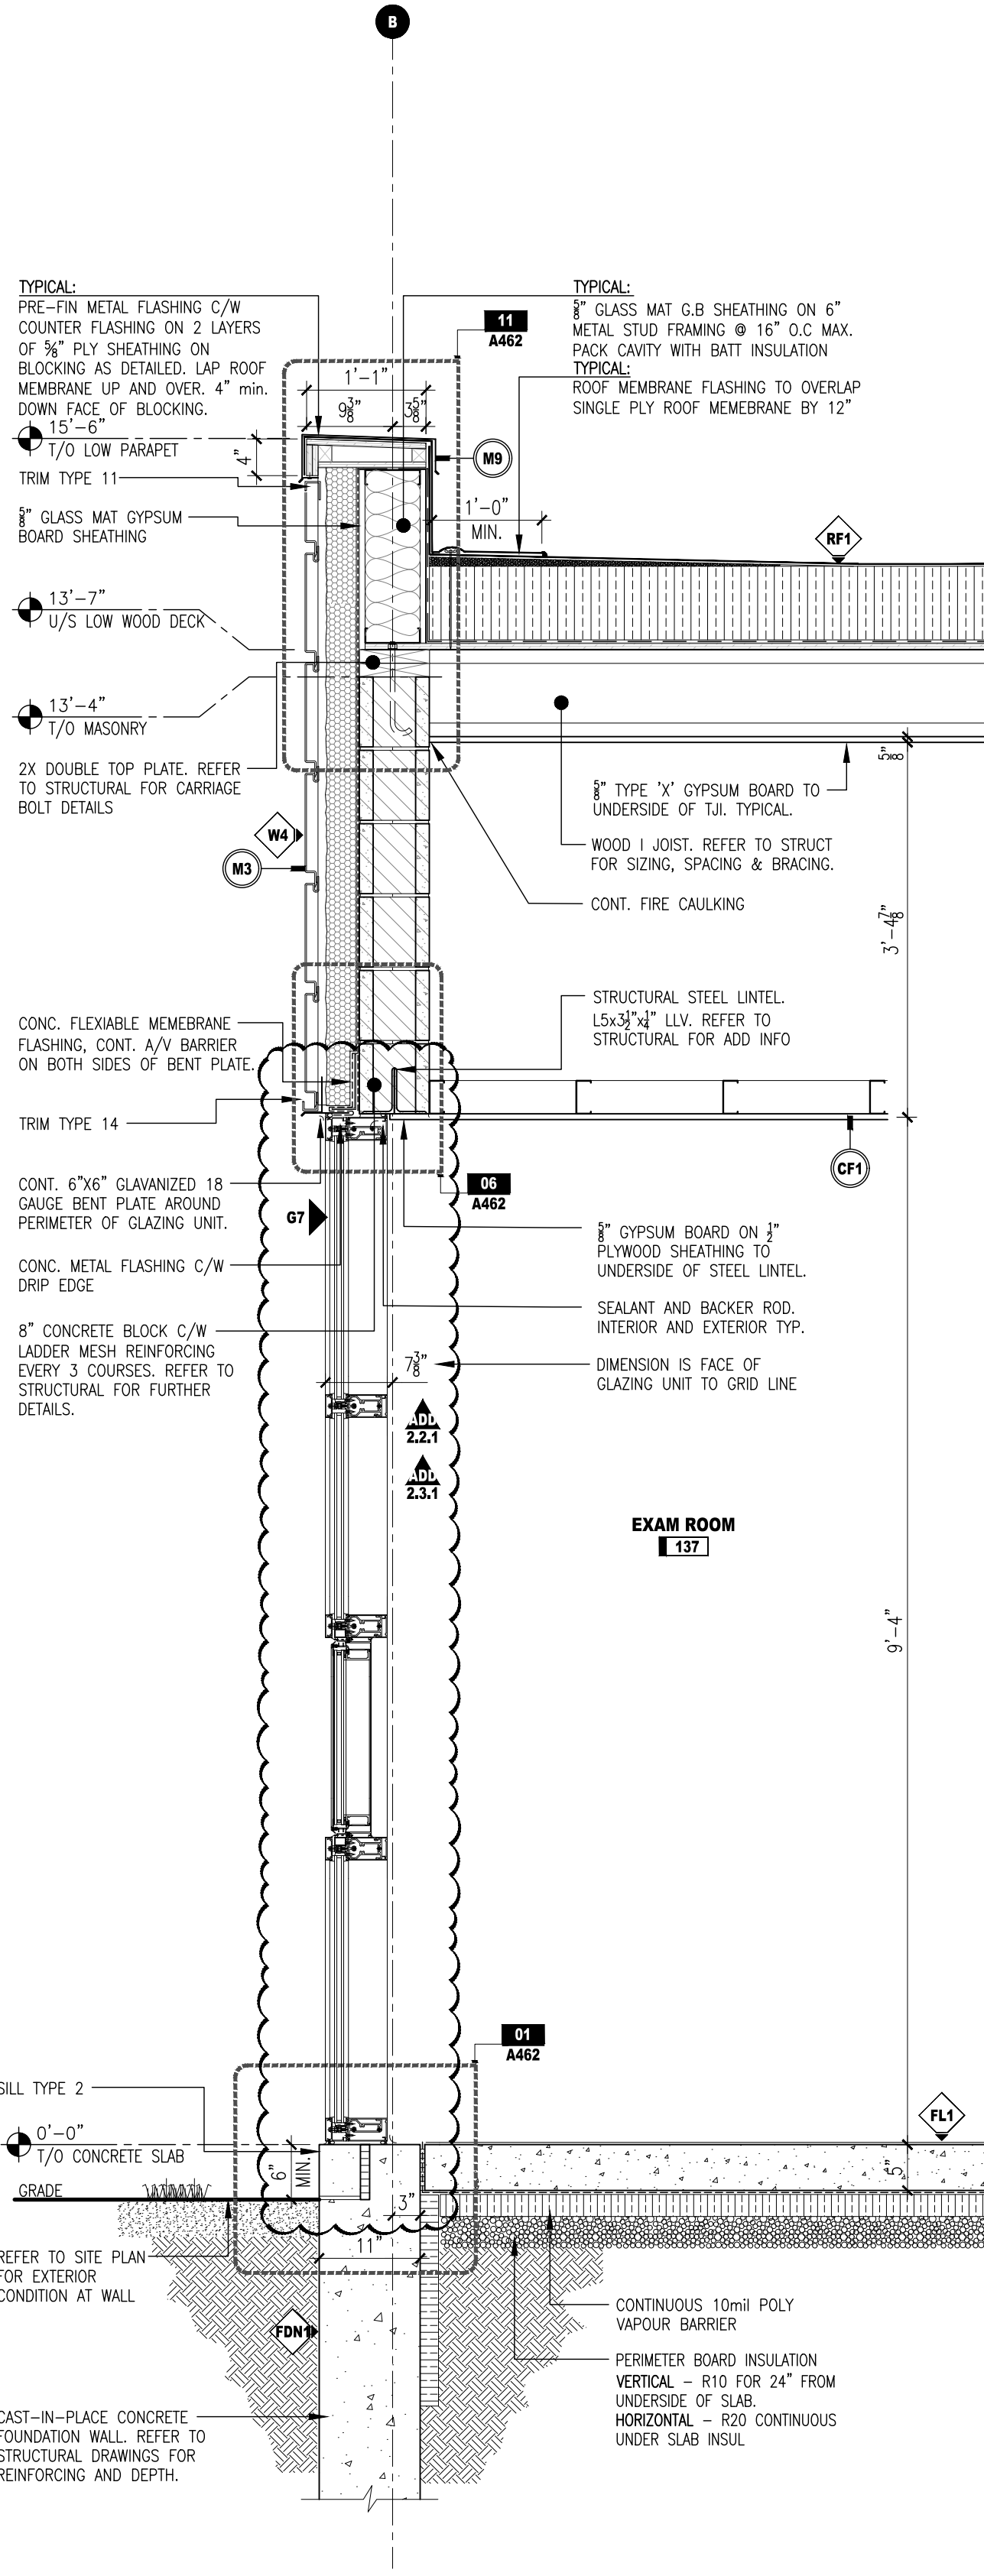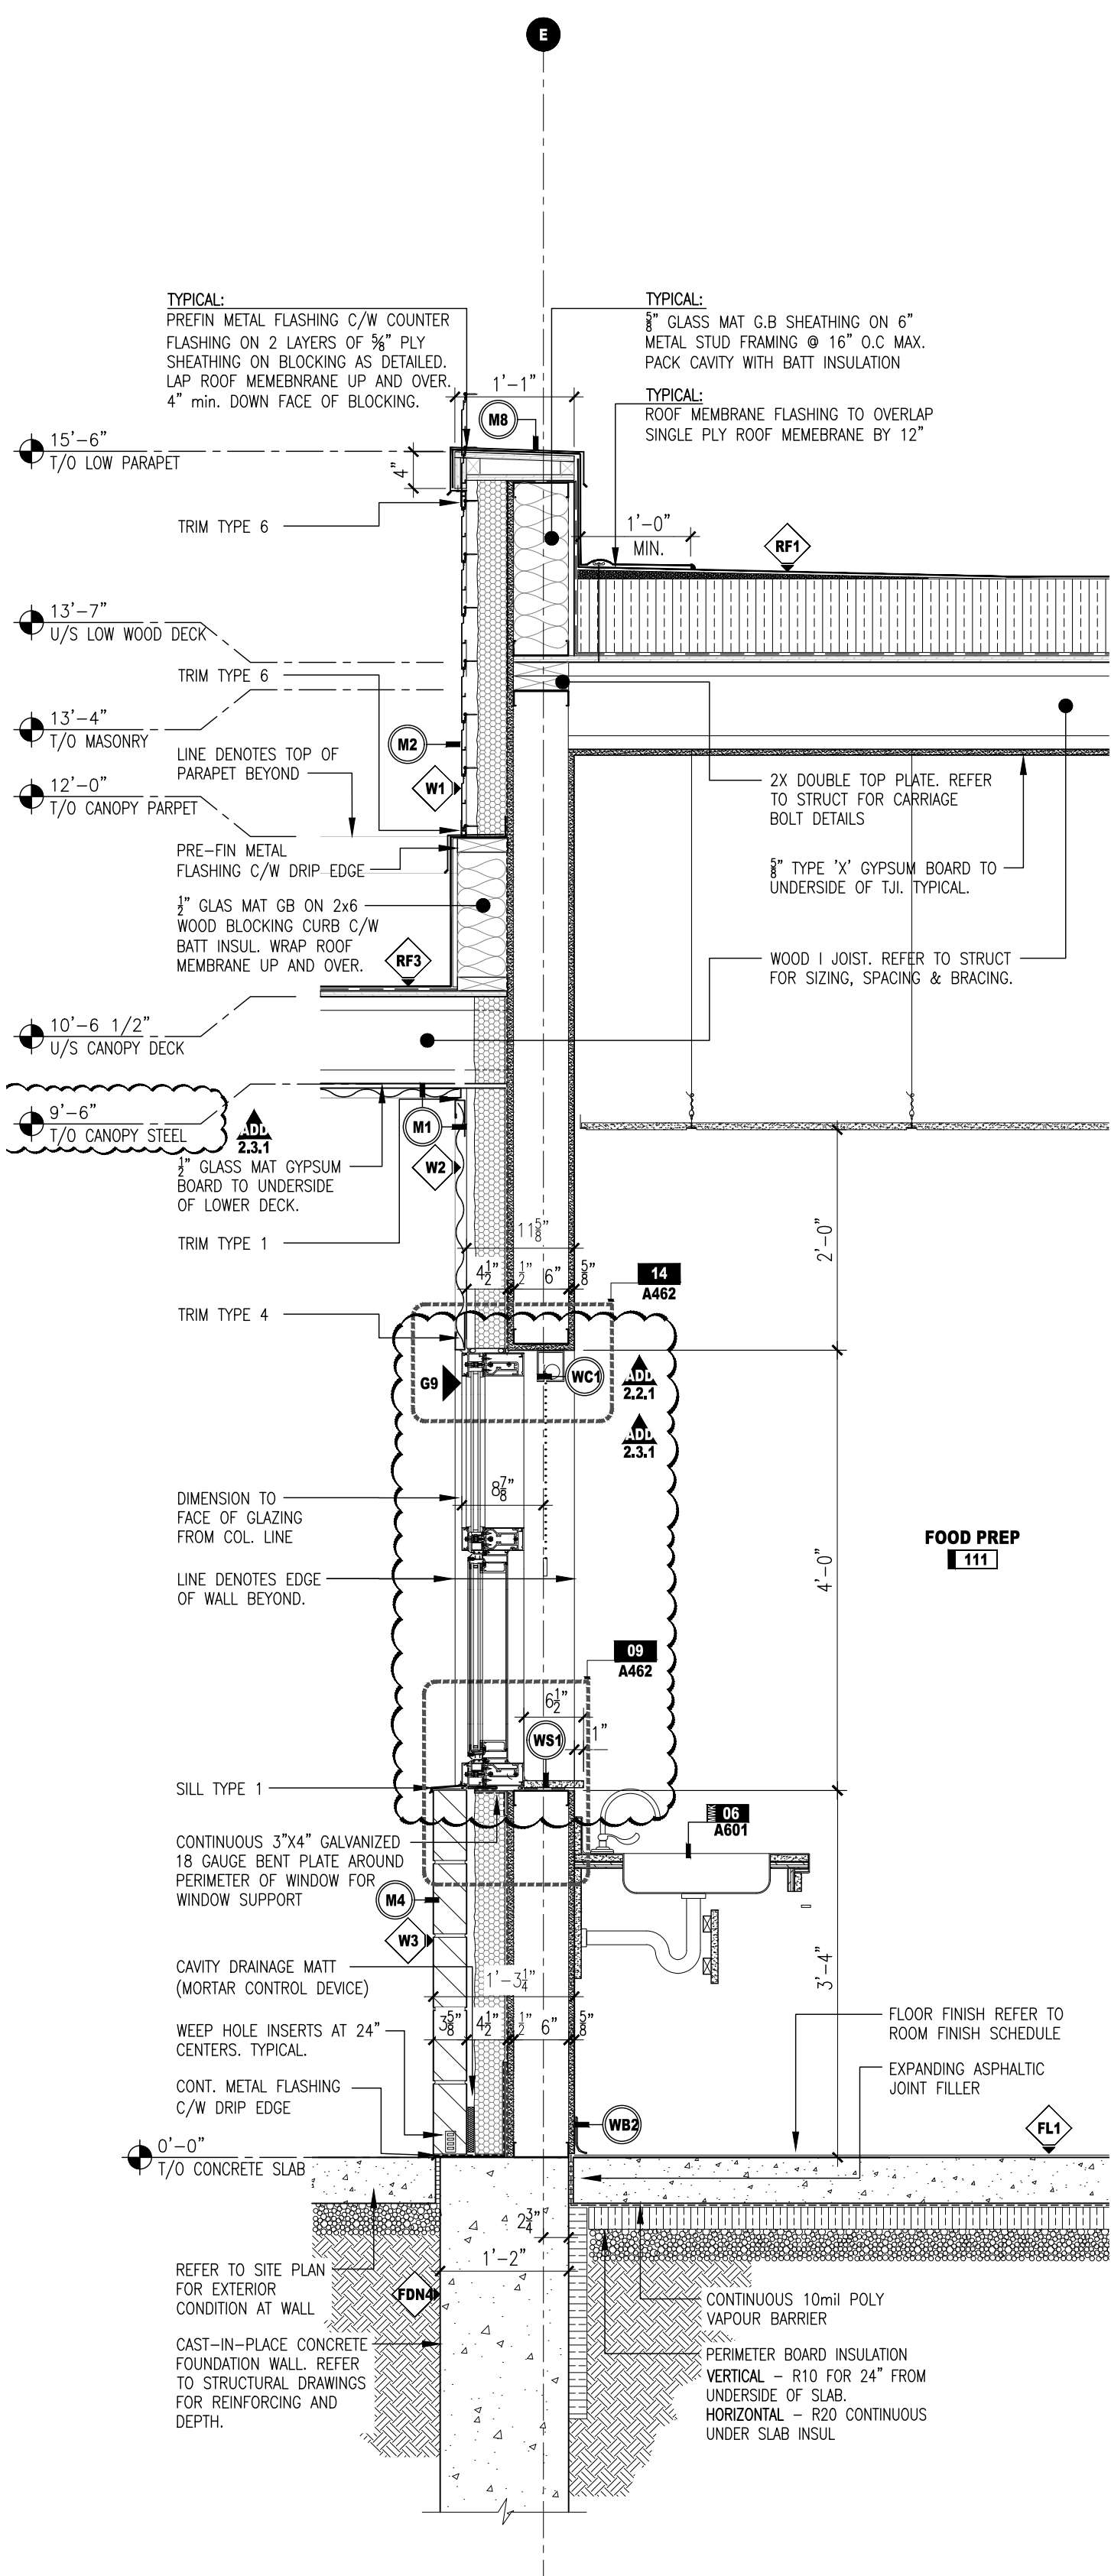

02 WALL SECTION
A425 SCALE: 3/4" = 1'-0"

NOTES	PROJECT IDENTIFICATION	DRAWING IDENTIFICATION	ORIENTATION	SUB-CONSULTANT	PRIME CONSULTANT	DISCIPLINE SEAL	DRAWING SUBMISSION(S)	INTERNAL INFO	COPYRIGHT 2024 [®]		
THE CONTRACTOR SHALL CHECK AND VERIFY ALL DIMENSIONS AND REPORT ANY ERRORS OR OMISSIONS TO THE ARCHITECT PRIOR TO COMMENCING OR PROCEEDING WITH ANY WORK ON THIS PROJECT. ALL DRAWINGS AND SPECIFICATIONS ARE THE PROPERTY OF THE ARCHITECT COPYRIGHT 2024 [®] . THESE DRAWINGS AND SPECIFICATIONS ARE DESIGNED FOR THE CLIENT AND THE PROPERTY INDICATED ON THESE DRAWINGS ONLY AND SHALL NOT BE CONSTRUCTED FOR ANY OTHER CLIENT OR ANY OTHER PROPERTY. DO NOT SCALE DRAWINGS.	BRANTFORD ANIMAL SHELTER 10 KRAEMER'S WAY BRANTFORD, ONTARIO N3V 0A5 <div><div></div>DESIGN REVIEW</div> <div><div></div>SITE PLAN APPROVAL</div> <div><div></div>BUILDING PERMIT</div> <div><div></div>BIDS DOCUMENTS</div> <div><div></div>CONTRACT DOCUMENTS</div> <div><div></div>CONSTRUCTION DOCUMENTS</div> <div><div></div>AS-BUILT DOCUMENTS</div>	GLAZING SCHEDULE WALL SECTIONS				<div>67 KING STREET WEST, CHATHAM ON N7M 1C7 TEL . 519.397.0943 E.MAIL . info@roastudio.com</div>		MM-DD-YY	ARCHITECTURE PROJECT ID DRAWN BY REVIEWED BY DATE SCALE ROA23-003 J.CASSIDY B.MARSCHNER 10-23-2024 AS NOTED	ADD2-2	
							4	ISSUED FOR ADDENDUM #2			10-25-2024
							3	ISSUED FOR BIDS			08-12-2024
							2	ISSUED FOR PERMIT			07-29-2024
1	ISSUED FOR 100% OWNERS REVIEW	05-29-2024									
NO.	DESCRIPTION	DATE									