


AREA OF WORK LEGEND

- AREA OF WORK FOR ROOFING REPLACEMENT
- EXISTING TO REMAIN AS-IS
- DUCTWORK AND INSULATION REQUIRING REPAIR AND REPLACEMENT. REF. TO MECH.
- PIPEWORK INSULATION REQUIRING REPAIR AND REPLACEMENT. REF. TO MECH.

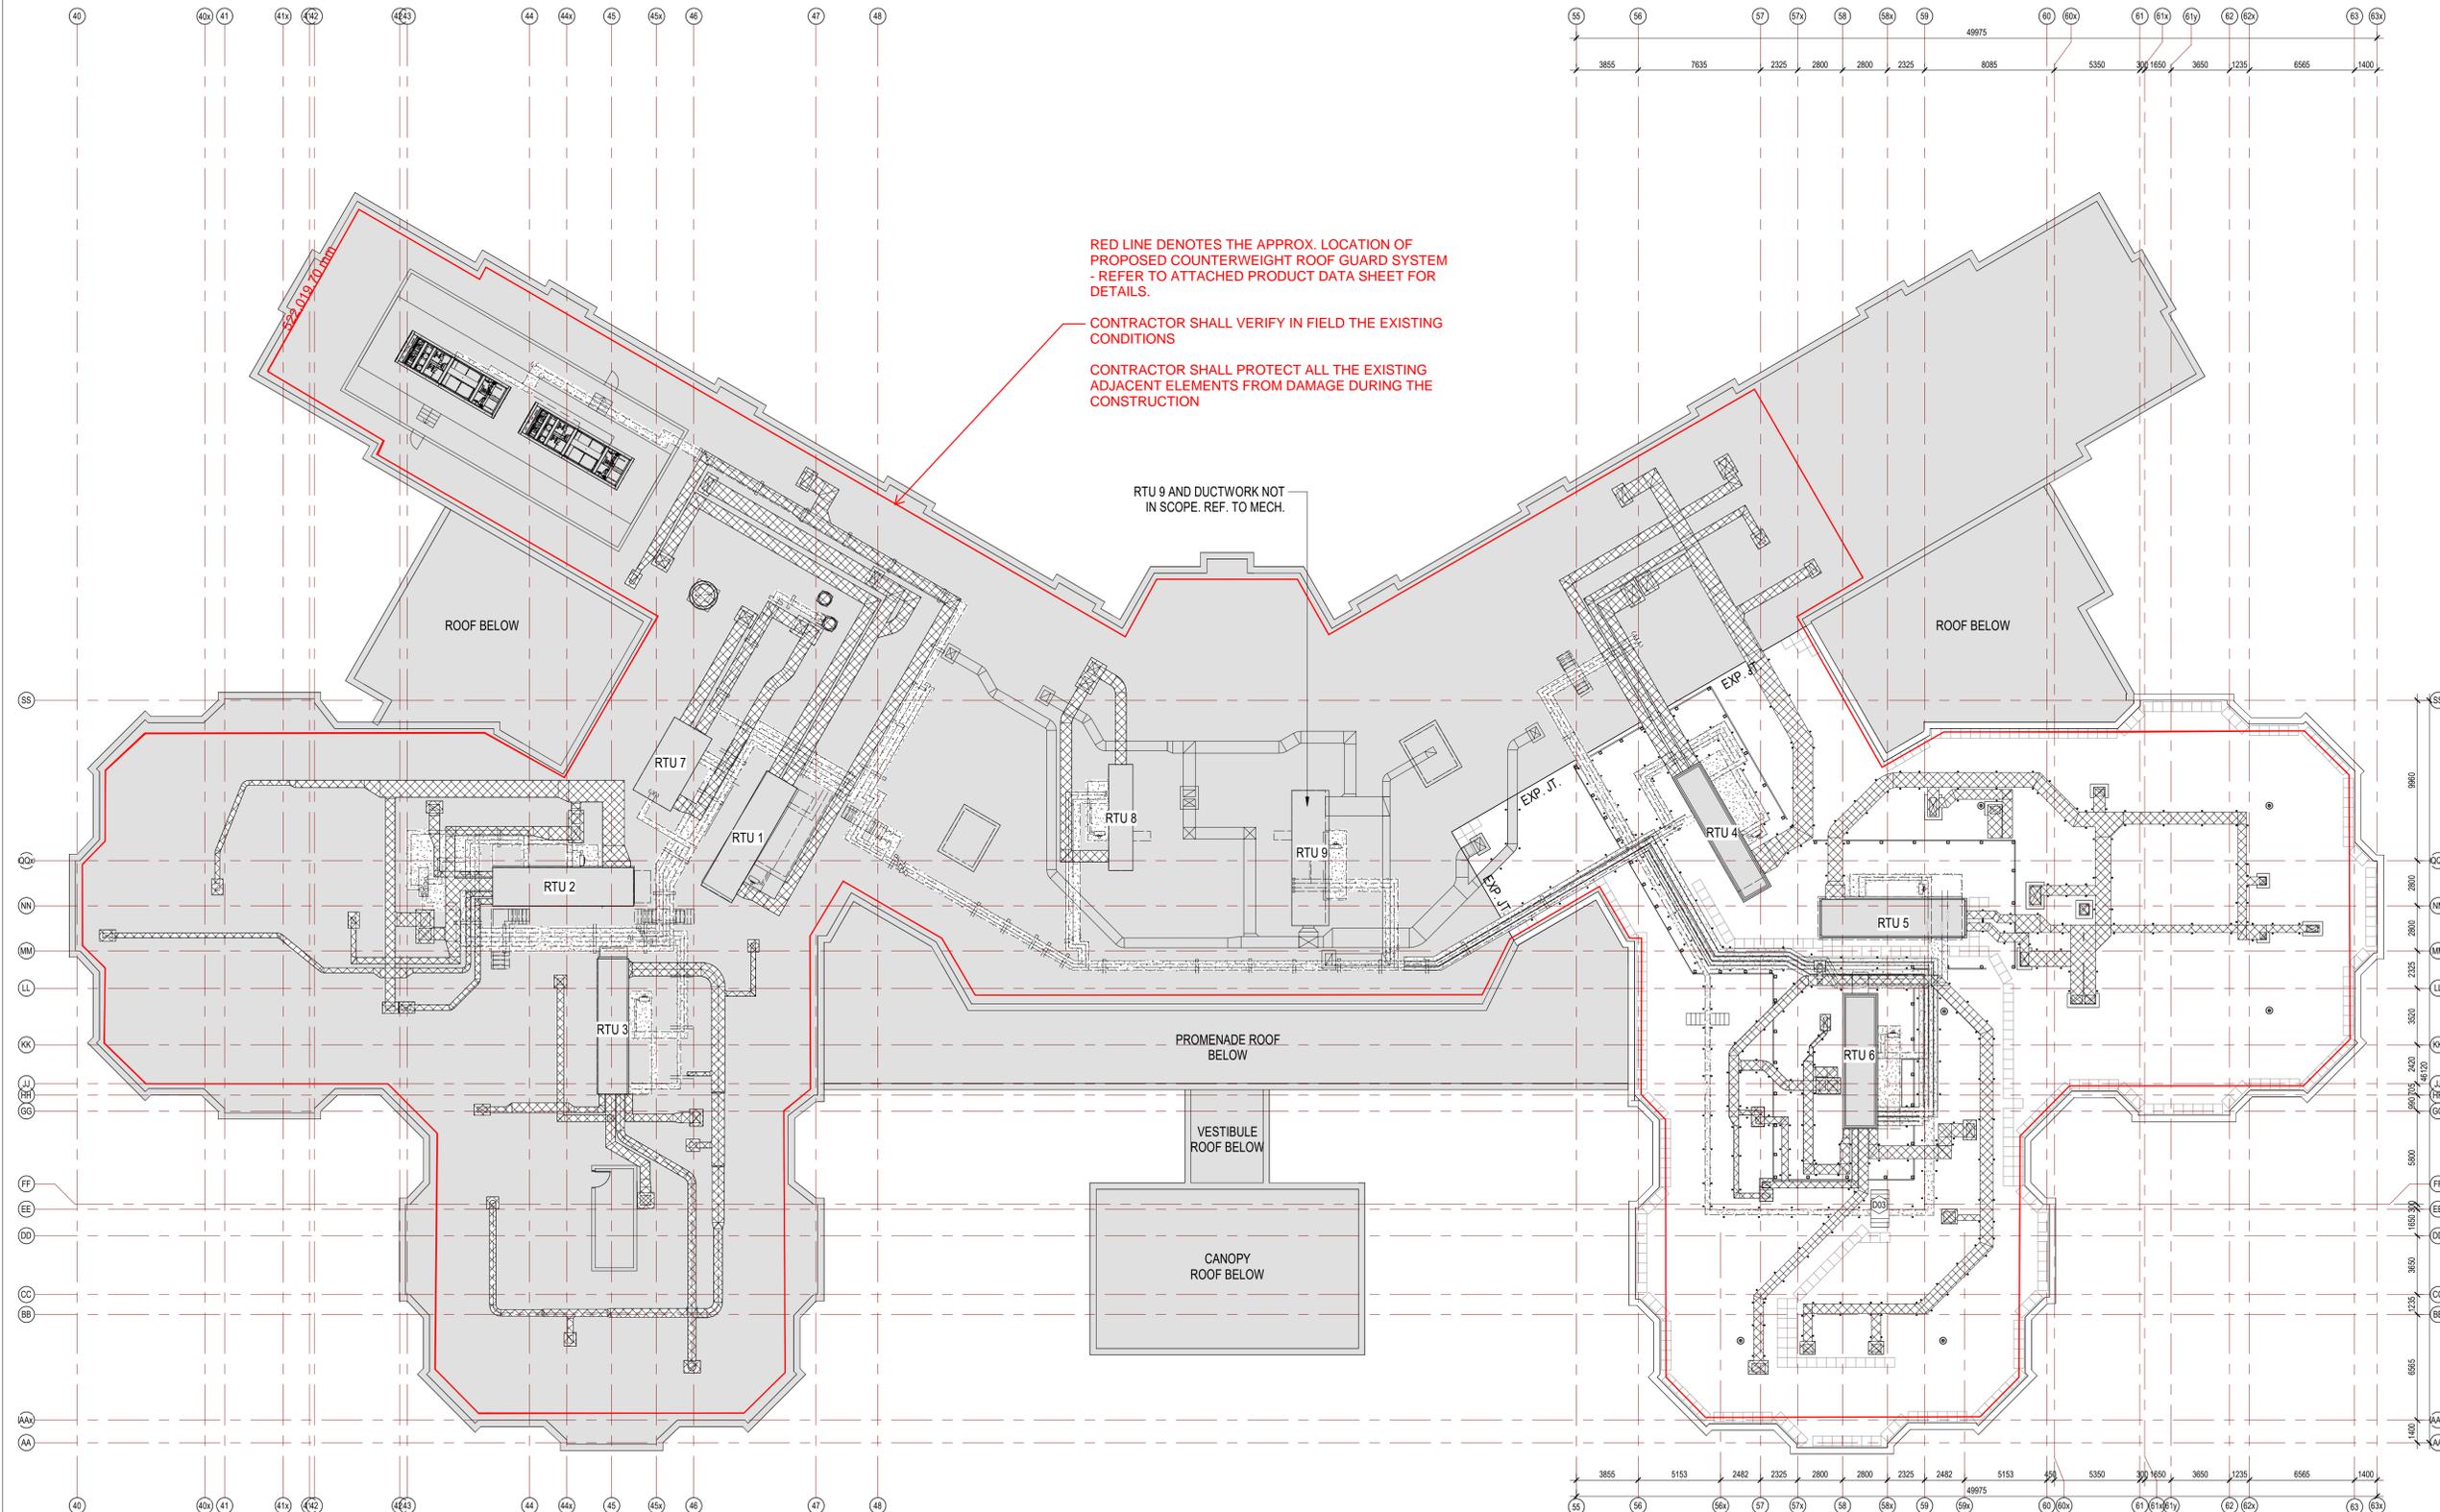

RED LINE DENOTES THE APPROX. LOCATION OF PROPOSED COUNTERWEIGHT ROOF GUARD SYSTEM - REFER TO ATTACHED PRODUCT DATA SHEET FOR DETAILS.

CONTRACTOR SHALL VERIFY IN FIELD THE EXISTING CONDITIONS

CONTRACTOR SHALL PROTECT ALL THE EXISTING ADJACENT ELEMENTS FROM DAMAGE DURING THE CONSTRUCTION

RTU 9 AND DUCTWORK NOT IN SCOPE. REF. TO MECH.

1 2025-03-11 ISSUED FOR ADDENDUM NO. 1 MSA
 # date: revision: by:
 reviso:

All drawing and specifications are the property of the architect. The contractor shall verify all dimensions and information on site and report any discrepancy to architect before.

CUMMER LODGE ROOF REPLACEMENT
 205 CUMMER AVE., NORTH YORK

PLANS - AREA OF WORK

scale 1 : 200
 drawn XH
 reviewed MY
 job 21504.F04
 plot 2024-03-04

drawing

A1.01