

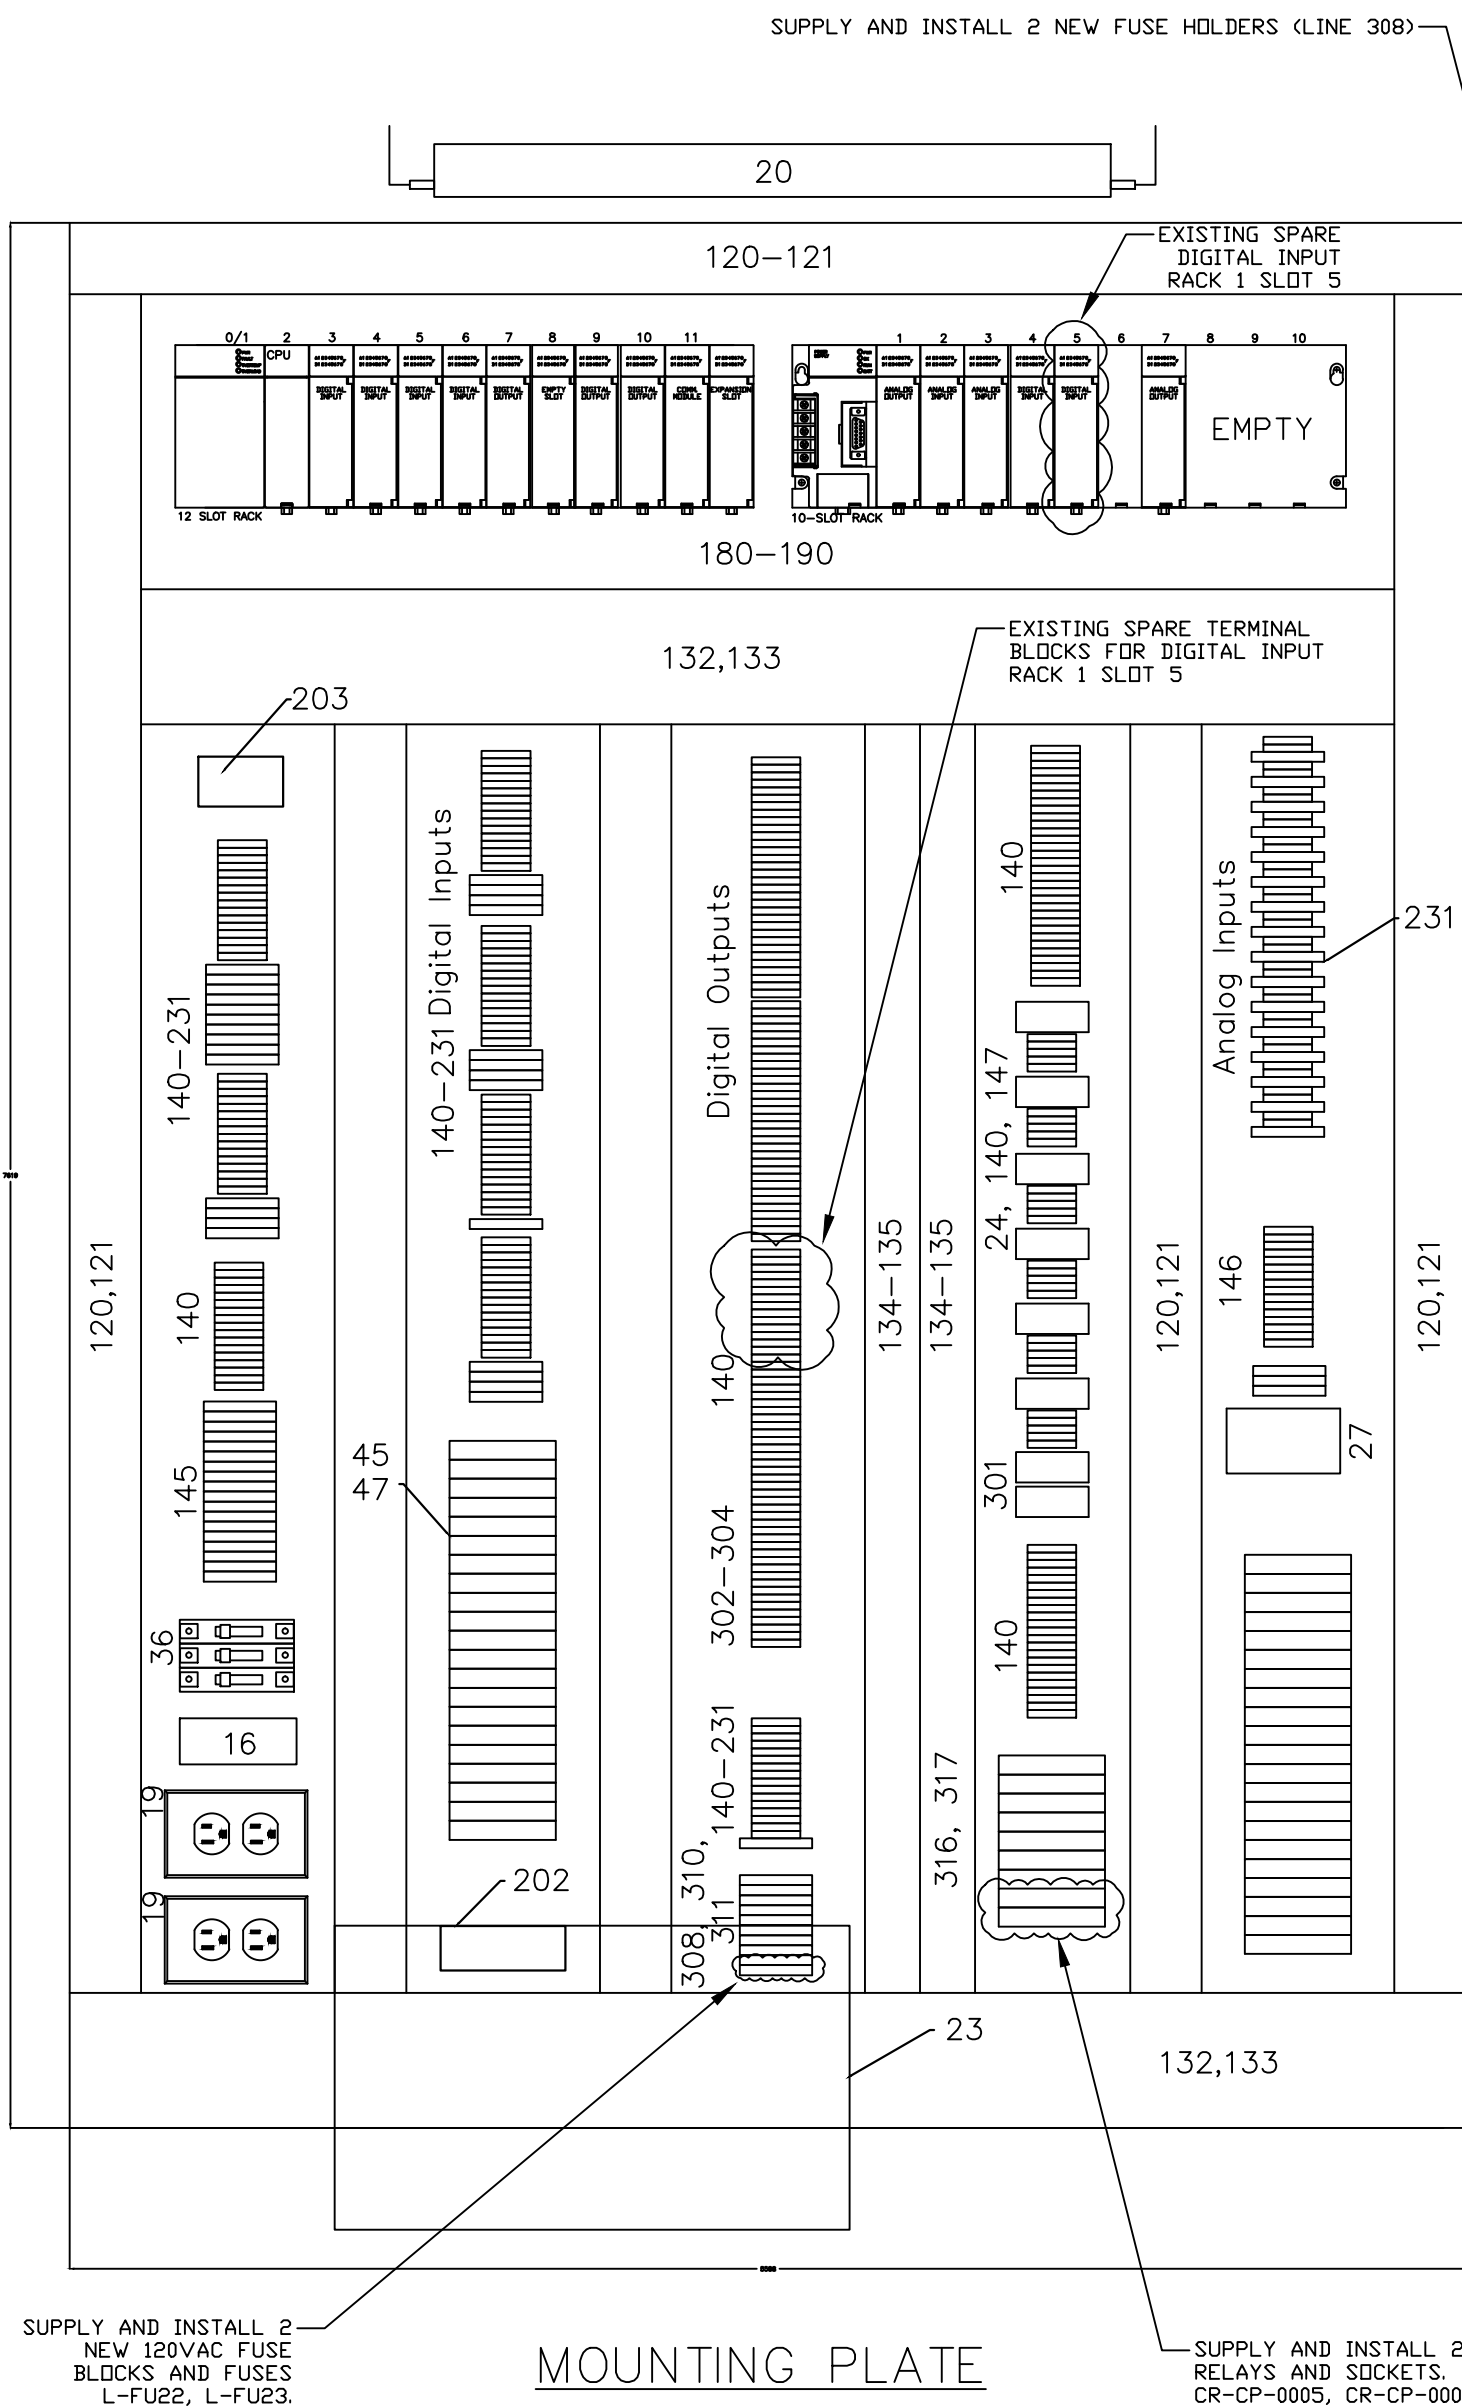


Drawing: J:\M16-0273 TOR_HARRISWTP-STANDBYGENERATOR\500_CAD\401-CAD\1-SS OR BUS SHEET\7 I&C\UPS AND FILTER CV SHUTDOWN\2F-2017-08-103_I106 SPC-RPU-1521 PANEL LAYOUT.DWG
Layout: TGG Date: 06/12/2025 Time: 03:15:22 PM

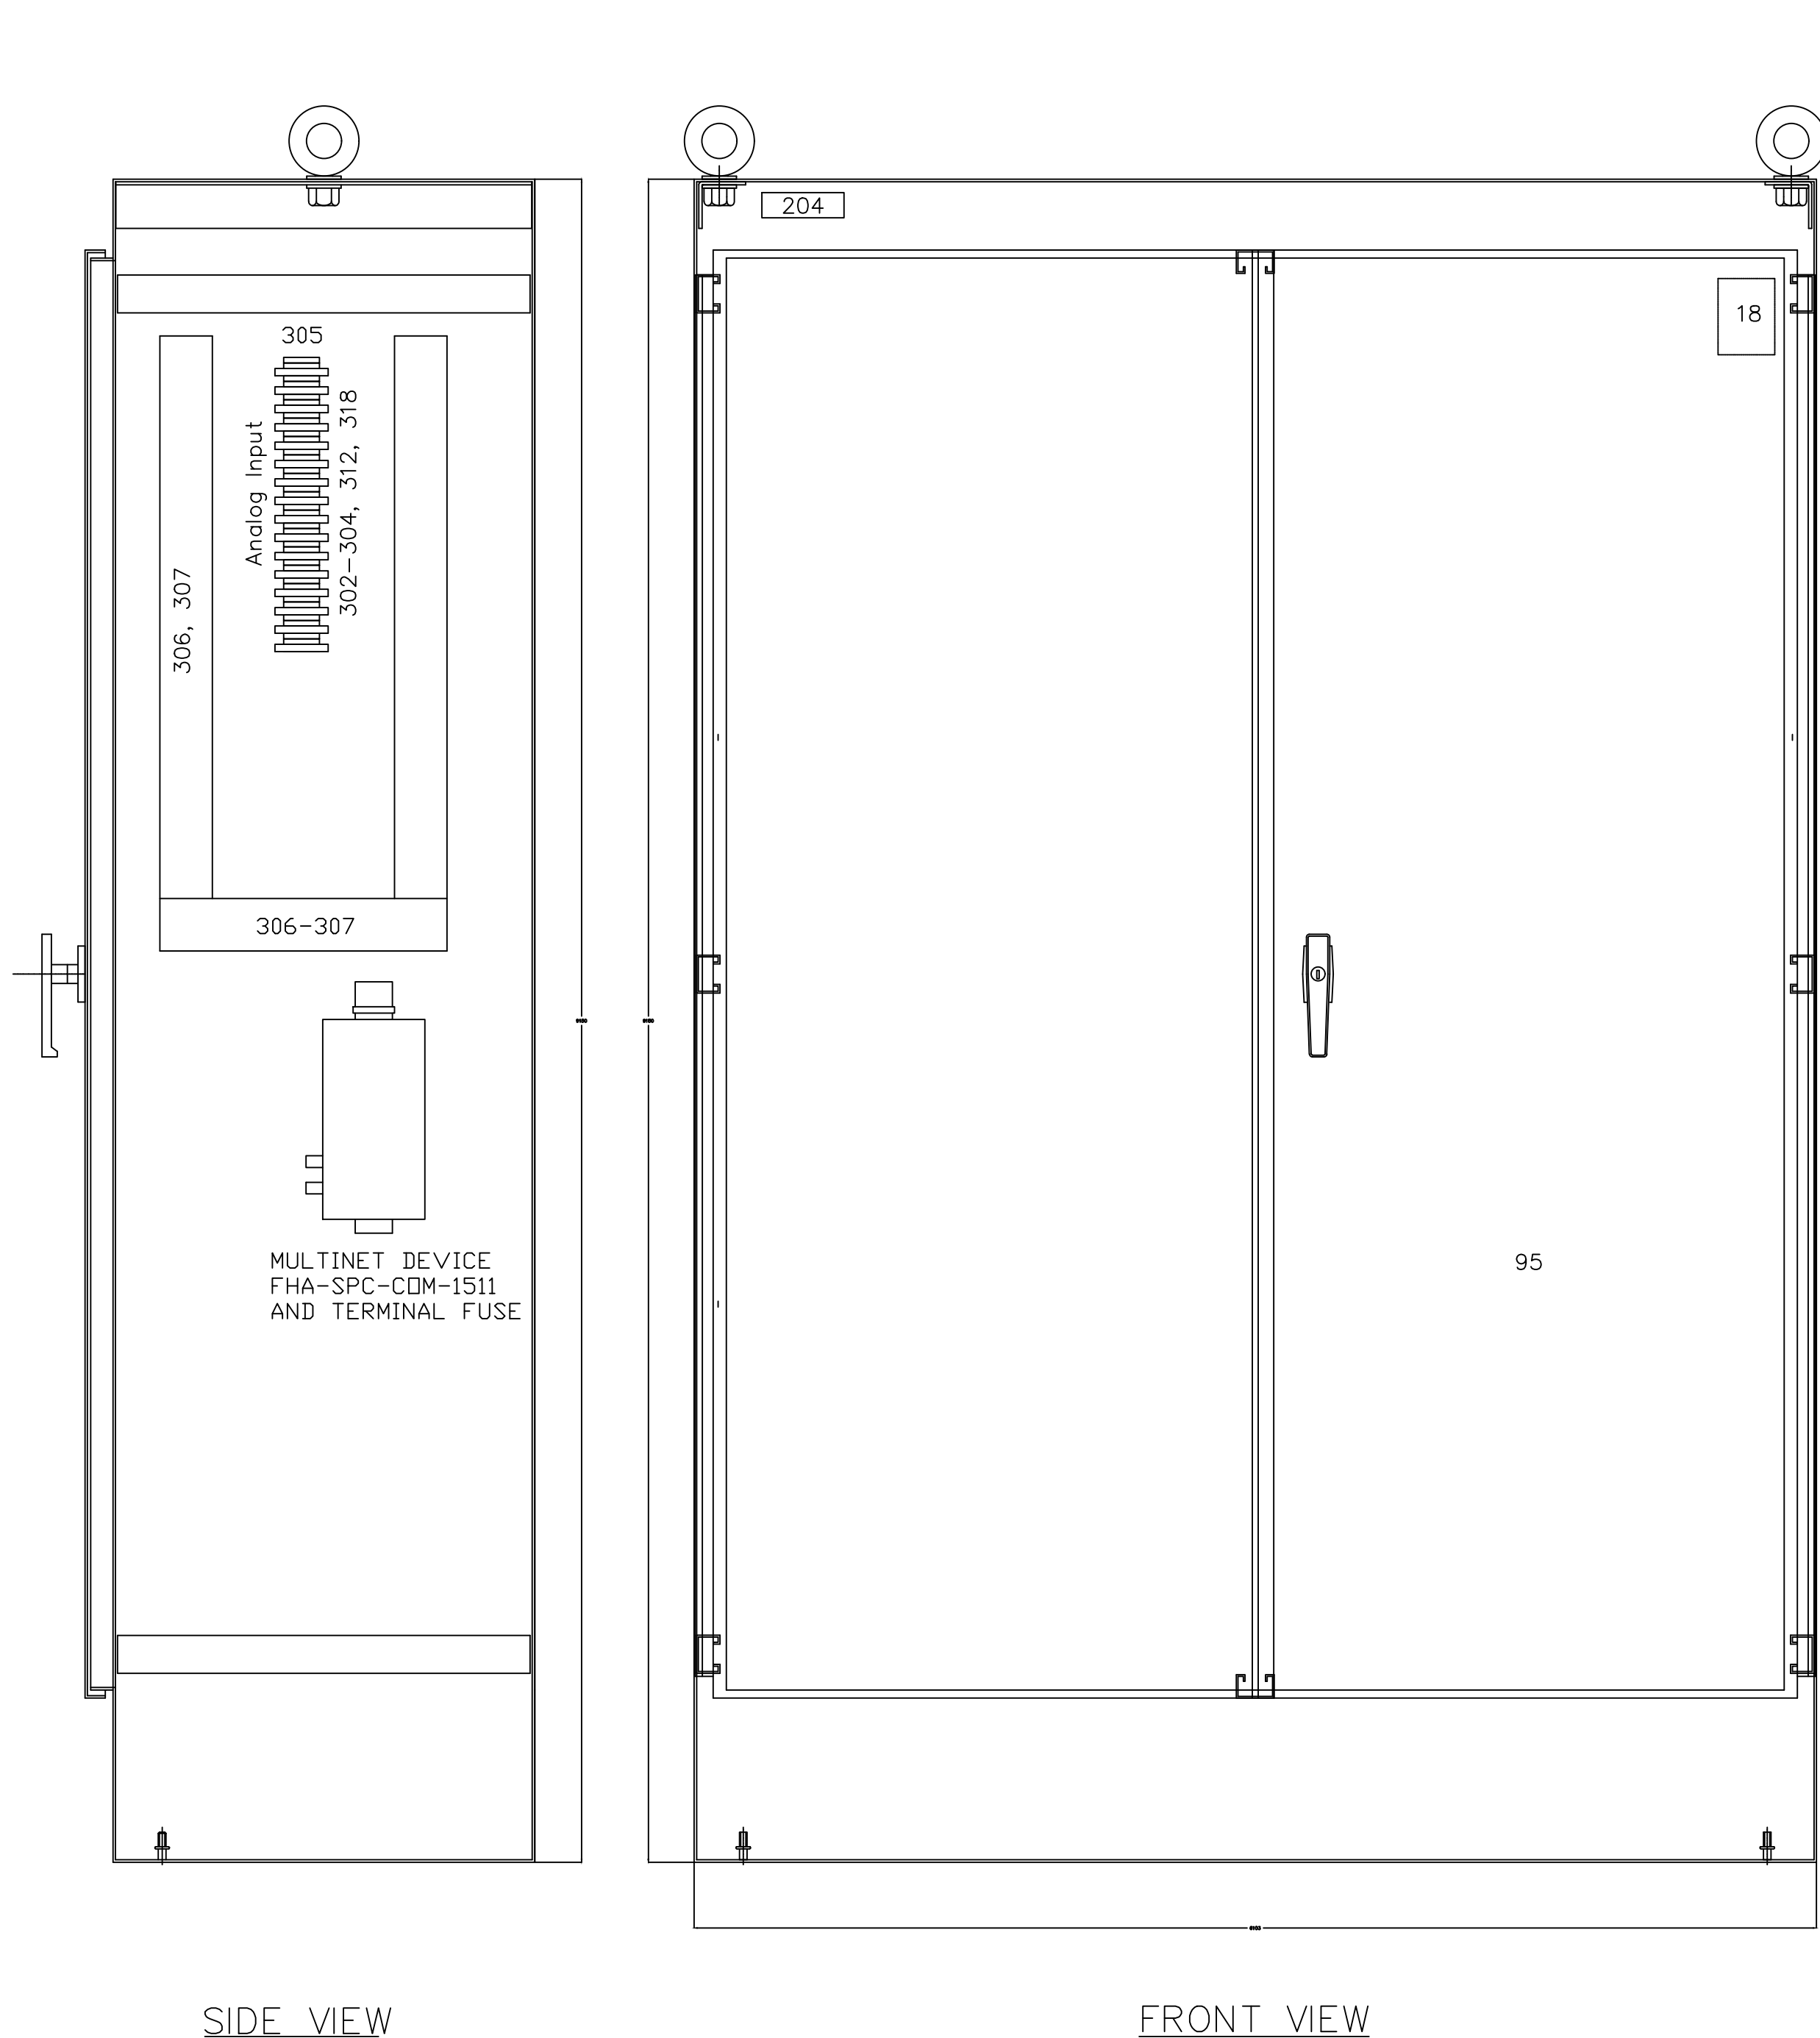

NOTES:
1. THIS DRAWING IS BASED ON EXISTING RECORD DRAWINGS. DETAILS AS DEPICTED MAY NOT BE AN ACCURATE REPRESENTATION OF EXISTING CONDITIONS. CONTRACTOR TO FIELD VERIFY EXISTING CONDITIONS AND SUPPLY AND CONFIGURE ALL COMPONENTS TO PROVIDE A FUNCTIONAL SYSTEM THAT MEETS THE DESIGN INTENTION OF THIS DRAWING.

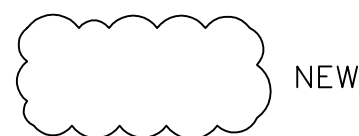

				TORONTO WATER ENGINEERING AND CONSTRUCTION SERVICES		R.C. HARRIS WATER TREATMENT PLANT INSTALLATION OF A STANDBY GENERATOR FOR CRITICAL LOADS SPC-RPU-1521 PANEL LAYOUT									
 100-175 GALAXY BOULEVARD TORONTO, ONTARIO, M9W 0C9 TEL 416 679 1930 FAX 416 675 4620 www.arcadis.com		COPYRIGHT: This drawing has been prepared solely for the intended use, thus any reproduction or distribution for any purpose other than authorized by ARCADIS is forbidden. Written dimensions shall have precedence over scaled dimensions. Contractor shall verify and be responsible for all dimensions and conditions on the job, and ARCADIS shall be informed of any variations from the dimensions and conditions shown on the drawing. Shop drawings shall be submitted to IBI Group for general concurrence before proceeding with fabrication.		ARCADIS Professional Services (Canada) Inc.		A 2025-06-10 ISSUED FOR ADDENDUM #1 C.H.		INSTRUMENTATION							
								DESIGN:	J.G.C.	DRAFTING:	M.H.	CHECK:	M.D.	CONTRACT No.	25ECS-MI-03HA
								SCALE:	N.T.S.			DRAWING NUMBER:	2F-2017-08-101	I106	
				WILLIAM FERNANDES, P. ENG. DIRECTOR, WATER TREATMENT AND SUPPLY		SIMON HOPTON, P. ENG. DIRECTOR DESIGN & CONSTRUCTION MAJOR INFRASTRUCTURE		DATE: 2024-09-30							